


T. 40 S., R. 14 W., W. M.

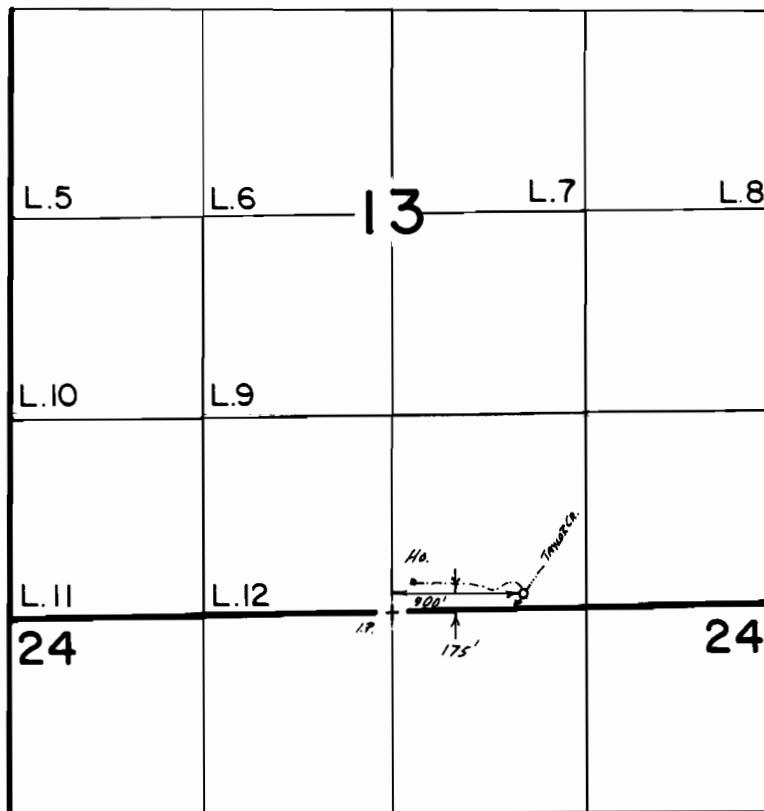

Scale 1" = 1320'



FINAL PROOF SURVEY
UNDER

Application No. 68156... Permit No. 48835...
IN NAME OF

JAMES E. BIRDSALL

Surveyed Sept. 3, 1987, by J. M. SCHMORDE