


T. 22 S., R. 7 W., W.M.

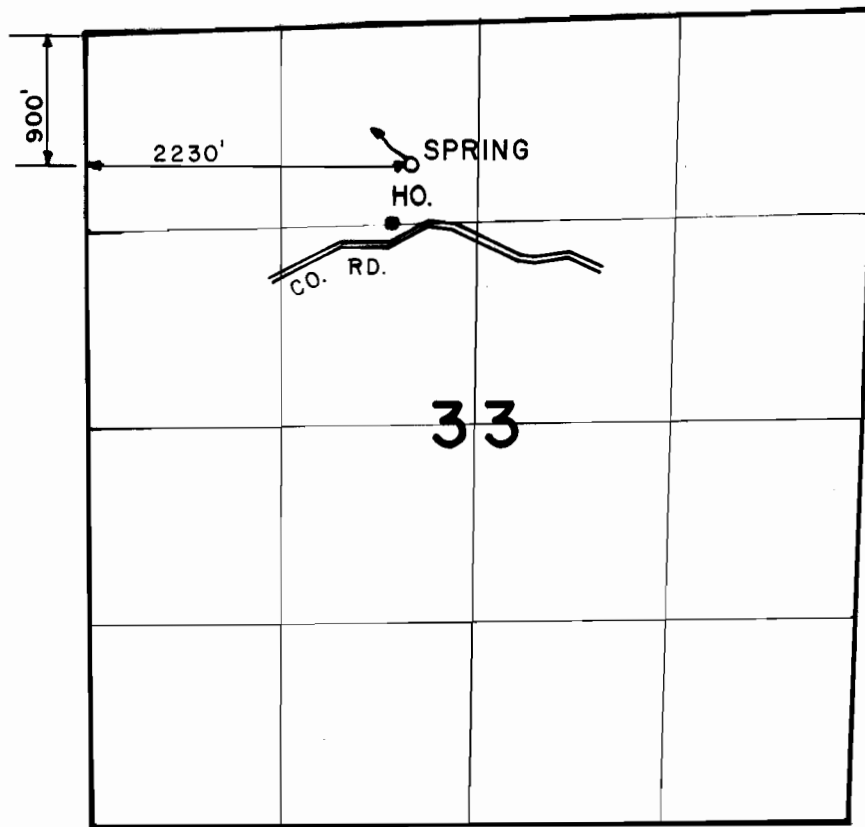

SCALE: 4" = 1 MILE

**FINAL PROOF SURVEY**  
UNDER

Application No. 68169... Permit No. 48881...  
IN NAME OF

**RUSSELL R. BRINE**

Surveyed SEPT. 9. 1987, by J.M. SCHMORDE.