


T.24S., R.7 W., W.M.

SECTION 33

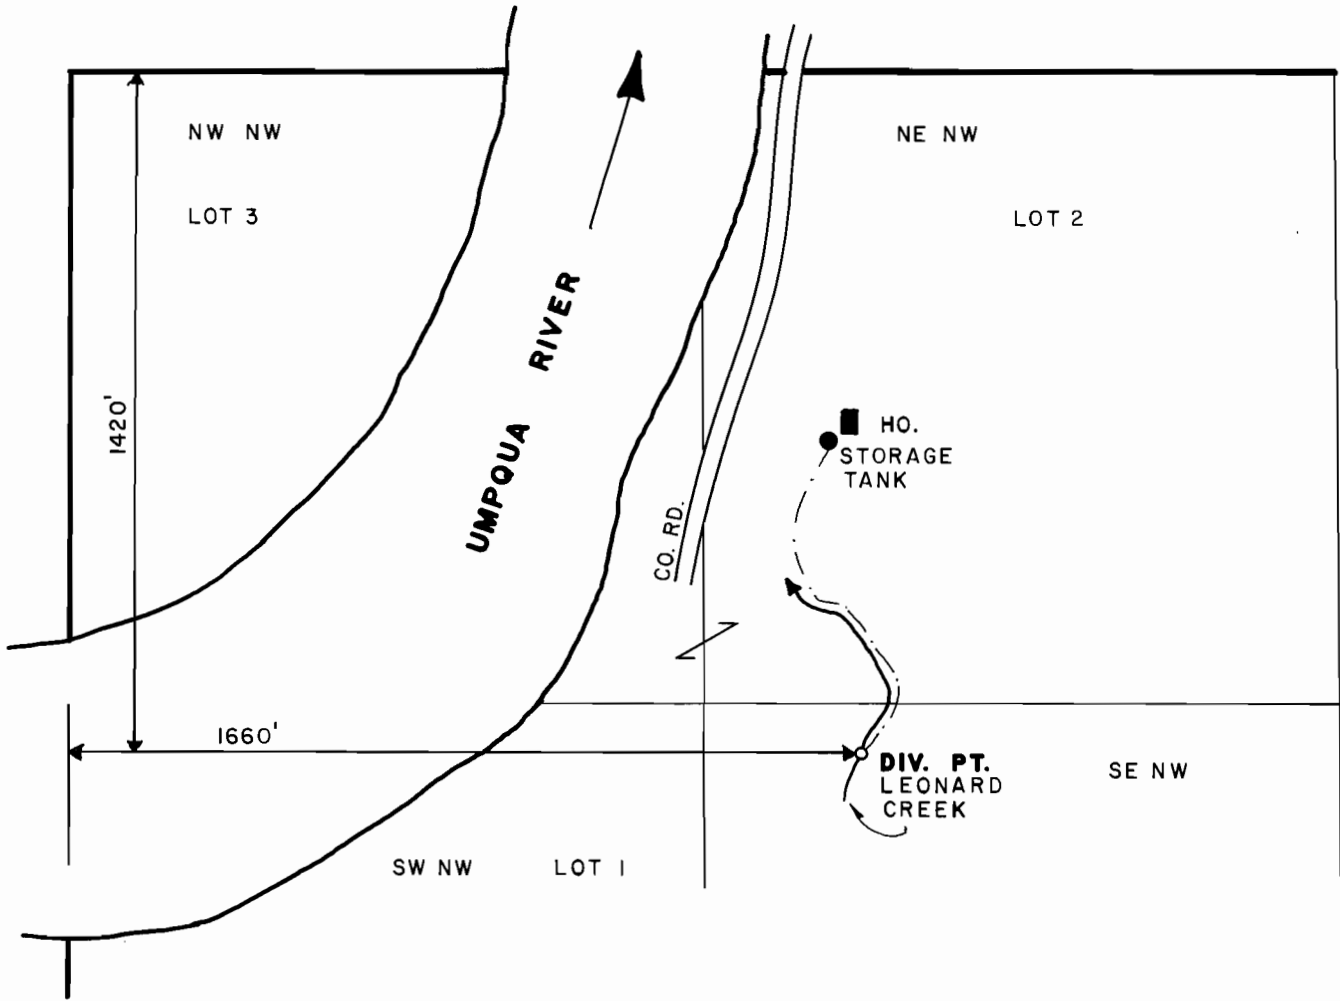

FINAL PROOF SURVEY UNDER



Application No. **68309** Permit No. **49276**
IN NAME OF

RONALD L. INGBERG

Surveyed **AUG. 19** 19**86**, by **J. M. SCHMORDE**