


# T. 29S., R. 4W., W. M.

## SECTION 29

SCALE: 1" = 400'

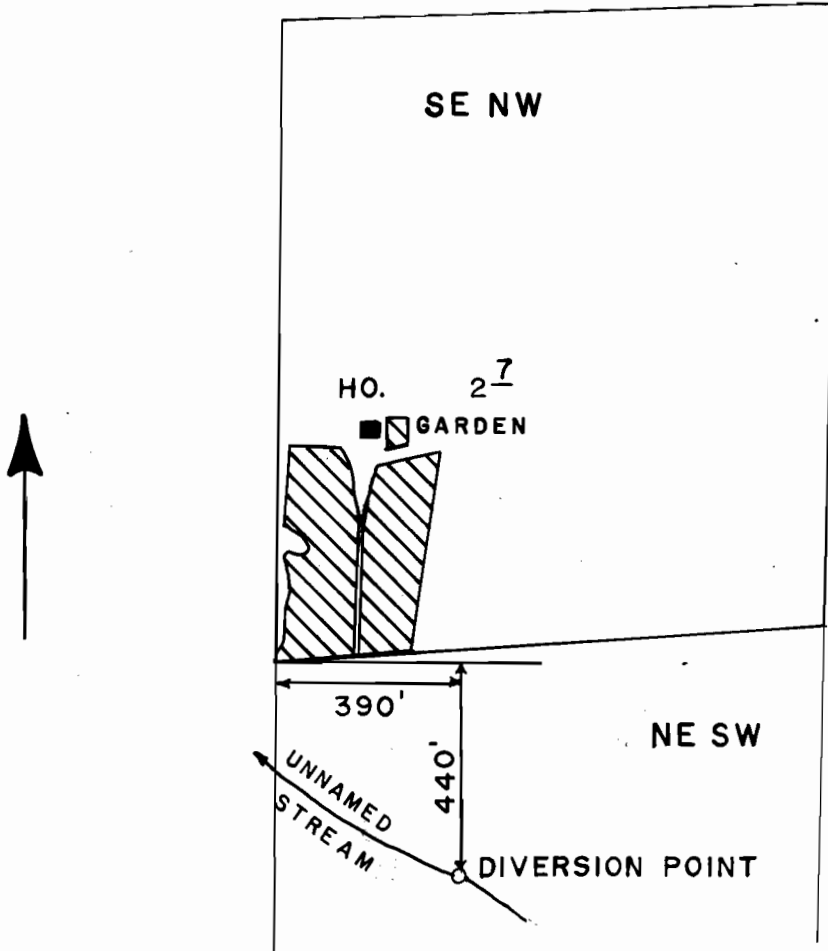

### FINAL PROOF SURVEY UNDER

Application No. 68421 Permit No. 49489  
IN NAME OF

GENE B. GARY AND EVELYN R. GARY

Surveyed MAY 8, 1986, by J.M. SCHMORDE