


# T13S, R11W, WM

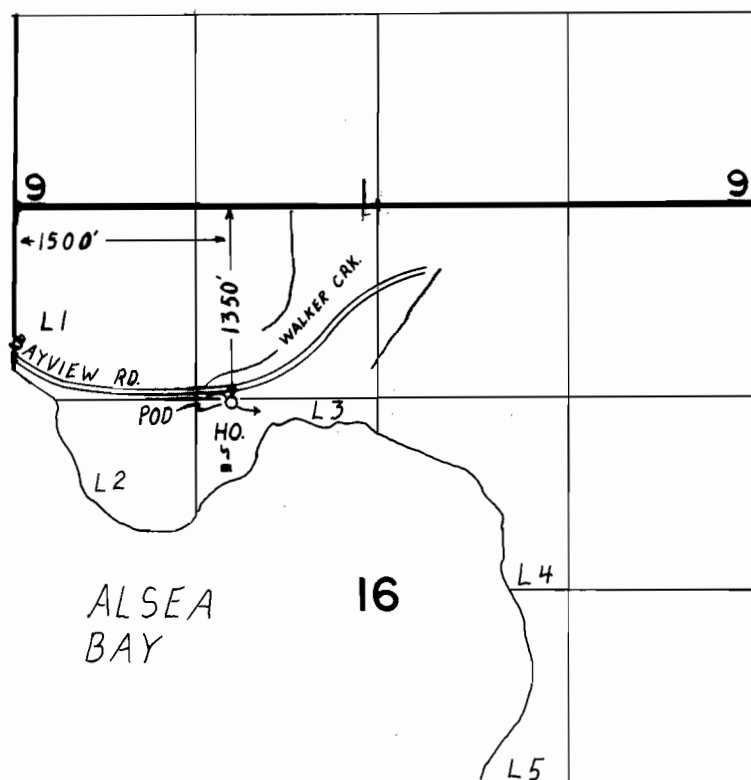

1" = 1320'

## FINAL PROOF SURVEY UNDER

Application No. ~~6.8.4.6.5~~ Permit No. ~~4.9.6.4.2~~....  
IN NAME OF

.....STEPHEN FARISH.....

Surveyed MAY 25, 1988, by T. M. WARREN..