


T. 283 S., R. 485 W., W.M.

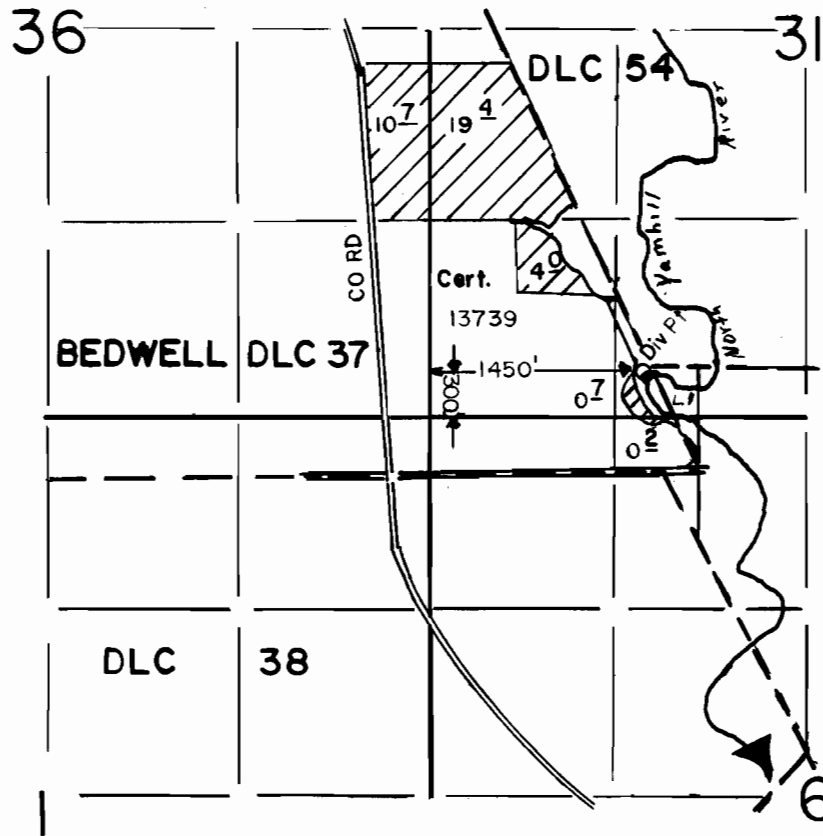

SCALE: 1" = 1320'

FINAL PROOF SURVEY
UNDER

Application No. 68539... Permit No. 49476.....
IN NAME OF

.....RONALD.....WALTER.....THIES.....

Surveyed JULY 29, 1987., by B.W. BISHOP.....