



T. 35 S., R. 1 W., W.M.

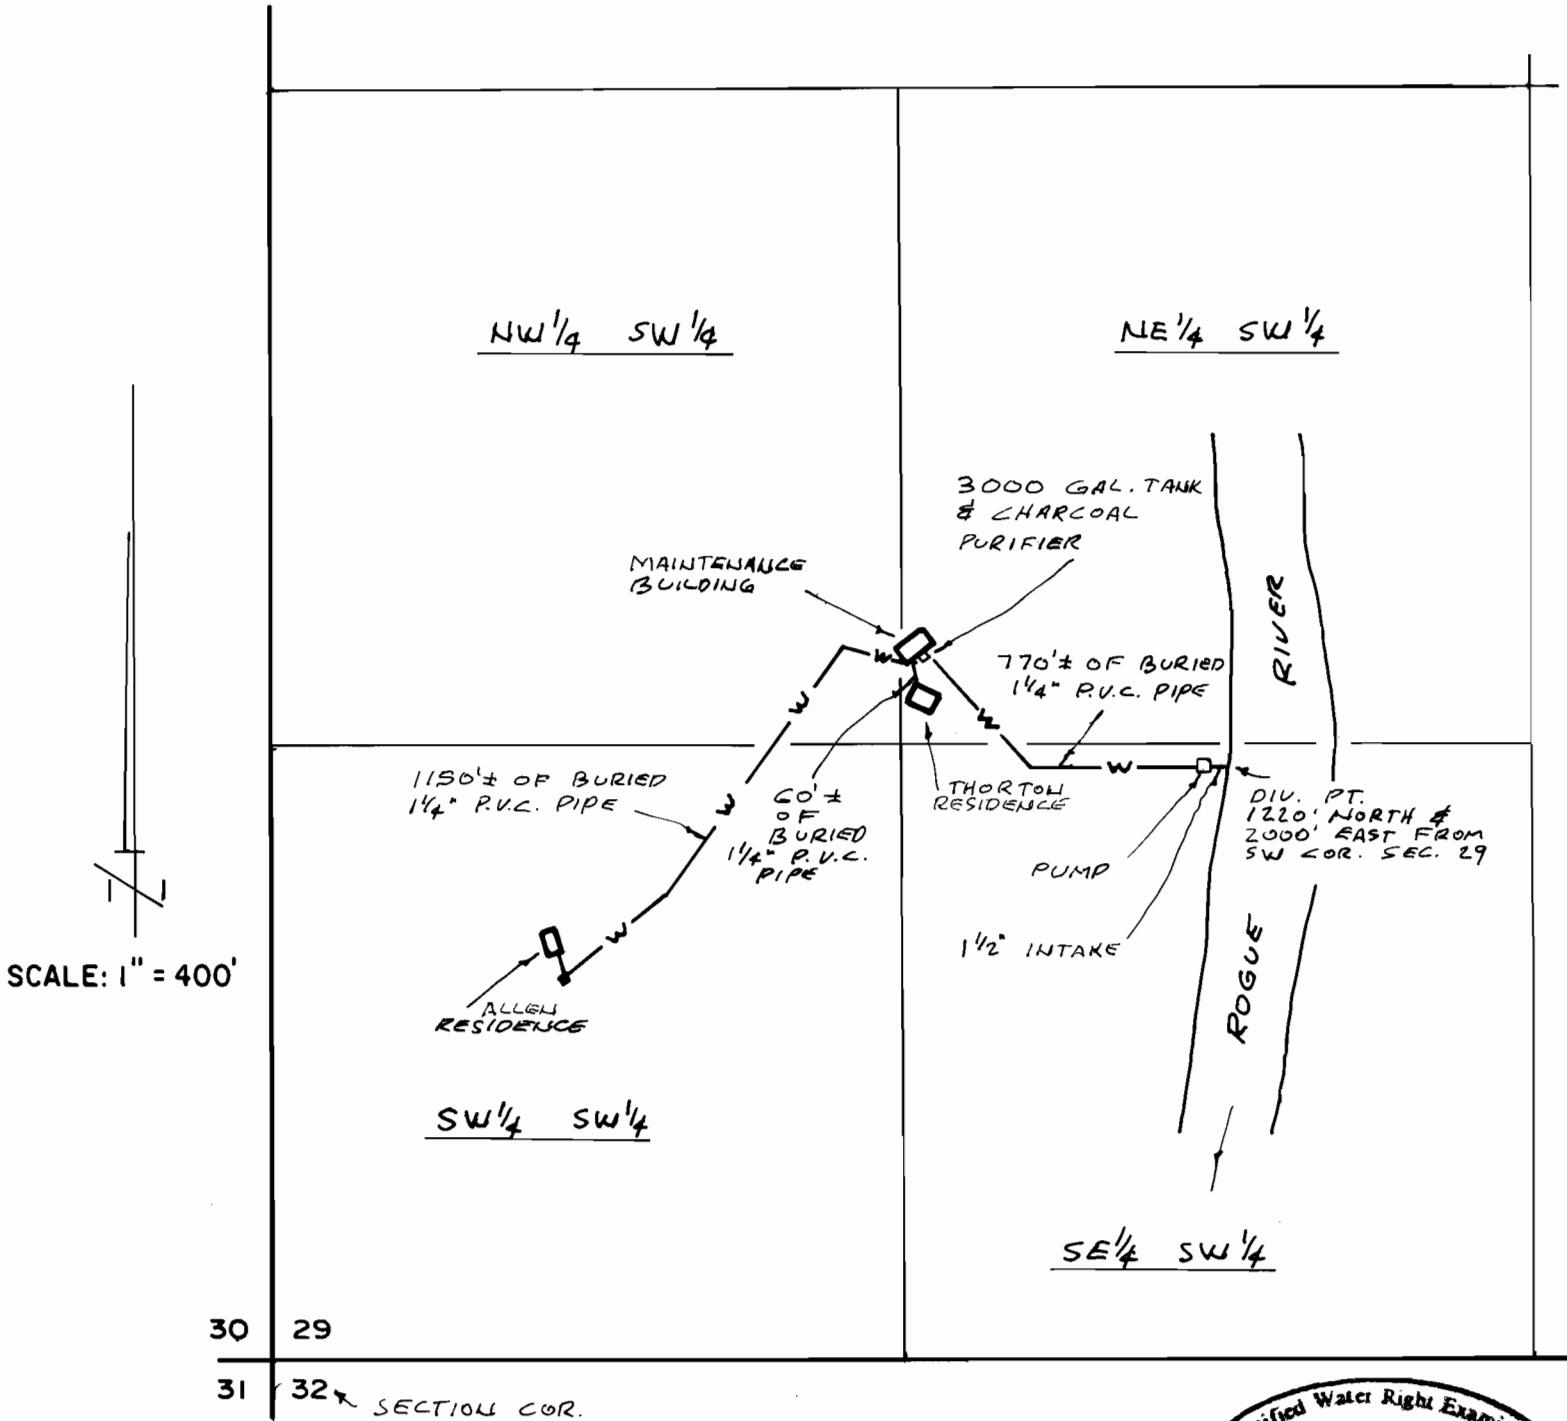

FINAL PROOF MAP

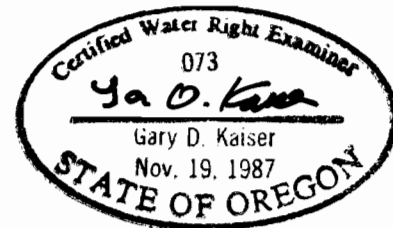

APPLICATION No. 69585 PERMIT No. 50273

IN NAME OF
HARRIS J. ALLEN

NOTE THIS MAP HAS BEEN PREPARED FOR WATER RIGHT PURPOSES ONLY, NOT FOR PROPERTY BOUNDARY LOCATIONS

MAP PREPARED NOV. 8, 1988 BY GARY D. KAISER