




T. 7 S., R. 1 W., W.M.

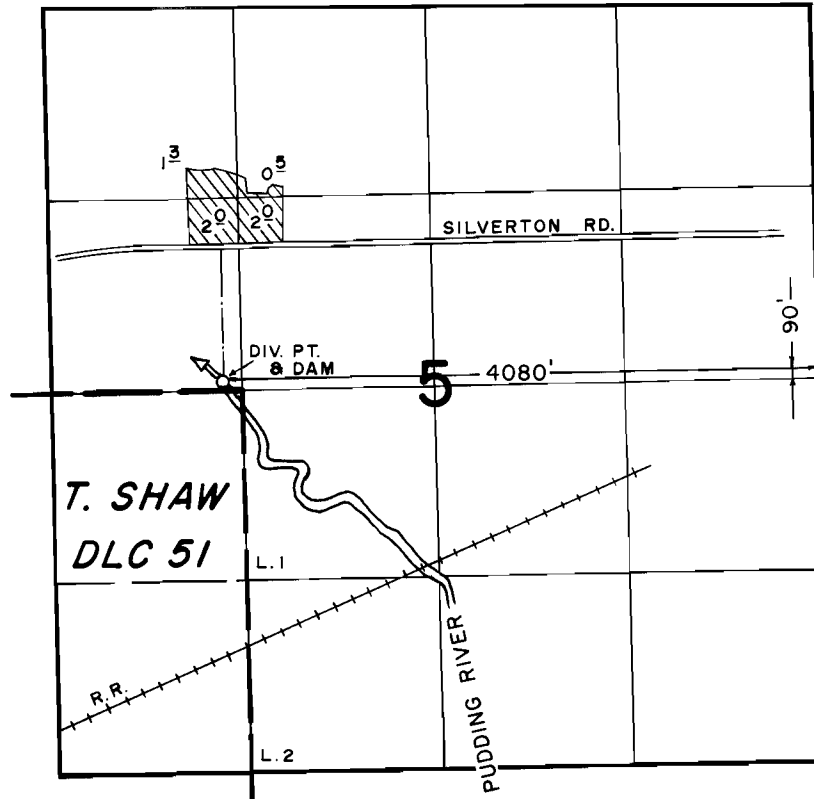

SCALE: 1" = 1320'

**FINAL PROOF SURVEY
UNDER**

Application No. 69185. Permit No. 50085...
IN NAME OF

.....JERRY SCHURTER.....

Surveyed MAY.30. 19.90., by T.M. WARREN