


T.11S.,R.40E.,W.M.

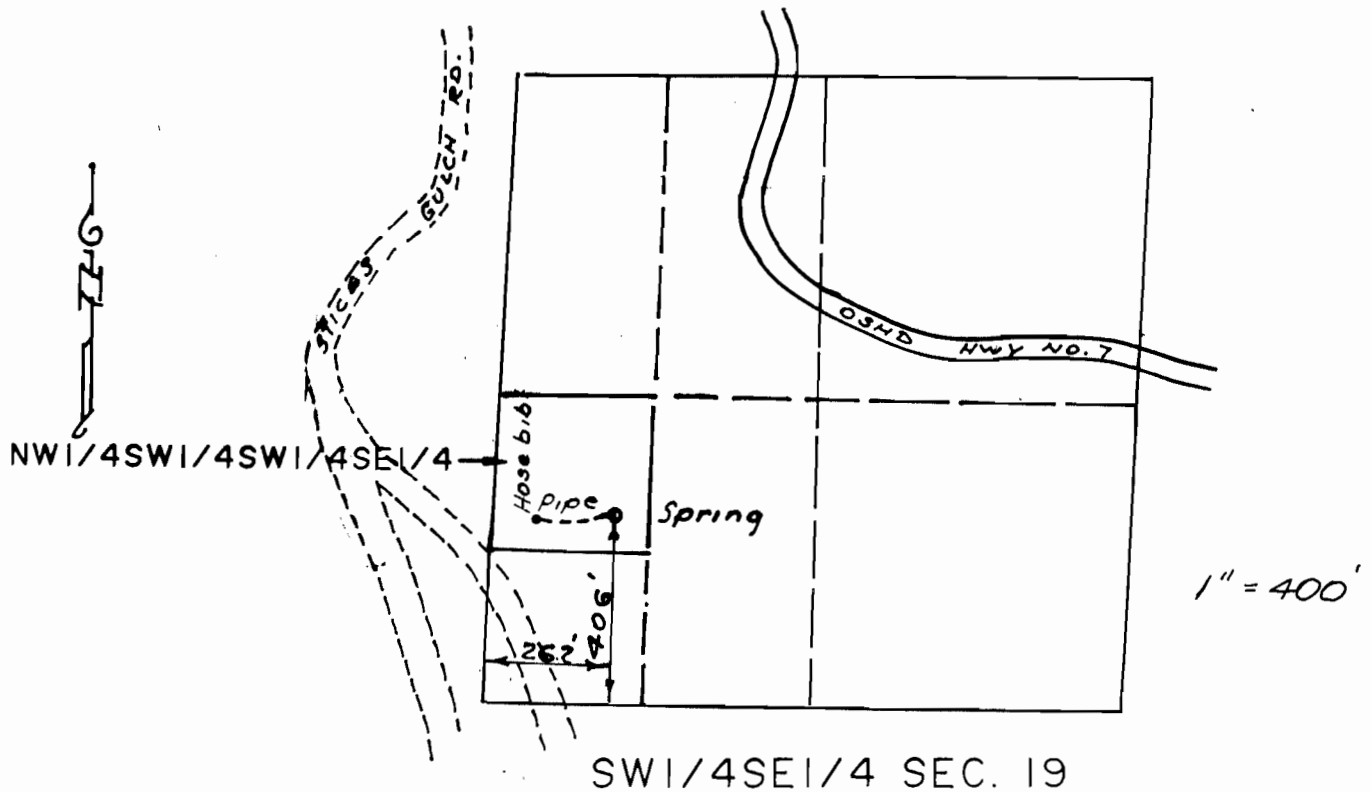

THE PURPOSE OF THIS MAP IS FOR IDENTIFYING THE LOCATION OF THE WATER RIGHT ONLY
AND IS NOT INTENDED TO PROVIDE LEGAL DIMENSIONS OF PROPERTY OWNERSHIP LINES

FINAL PROOF SURVEY
UNDER

Application No. 69216..... Permit No. 50599.....

IN NAME OF

AYLETT H. DAVIDSON

Surveyed..... APRIL 7..... 1991

