(Revised July 1941)

UNITED STATES DEPARTMENT OF AGRICULTURE
FOREST SERVICE

50918

RECEIVED
MAY 13 1980
WATER RESOURCES DEPT
SALEM, OREGON

FIELD MAP SHEET

T. 40S. R. 22E. Sec. 29 Subdiv. FREMONT N.F.

Scale 4 inches = 1 Mile

APPLICATION NO. Application No. 60131
PERMIT NO. Permit No. 50918
⊙=WATER SOURCE

NORTH

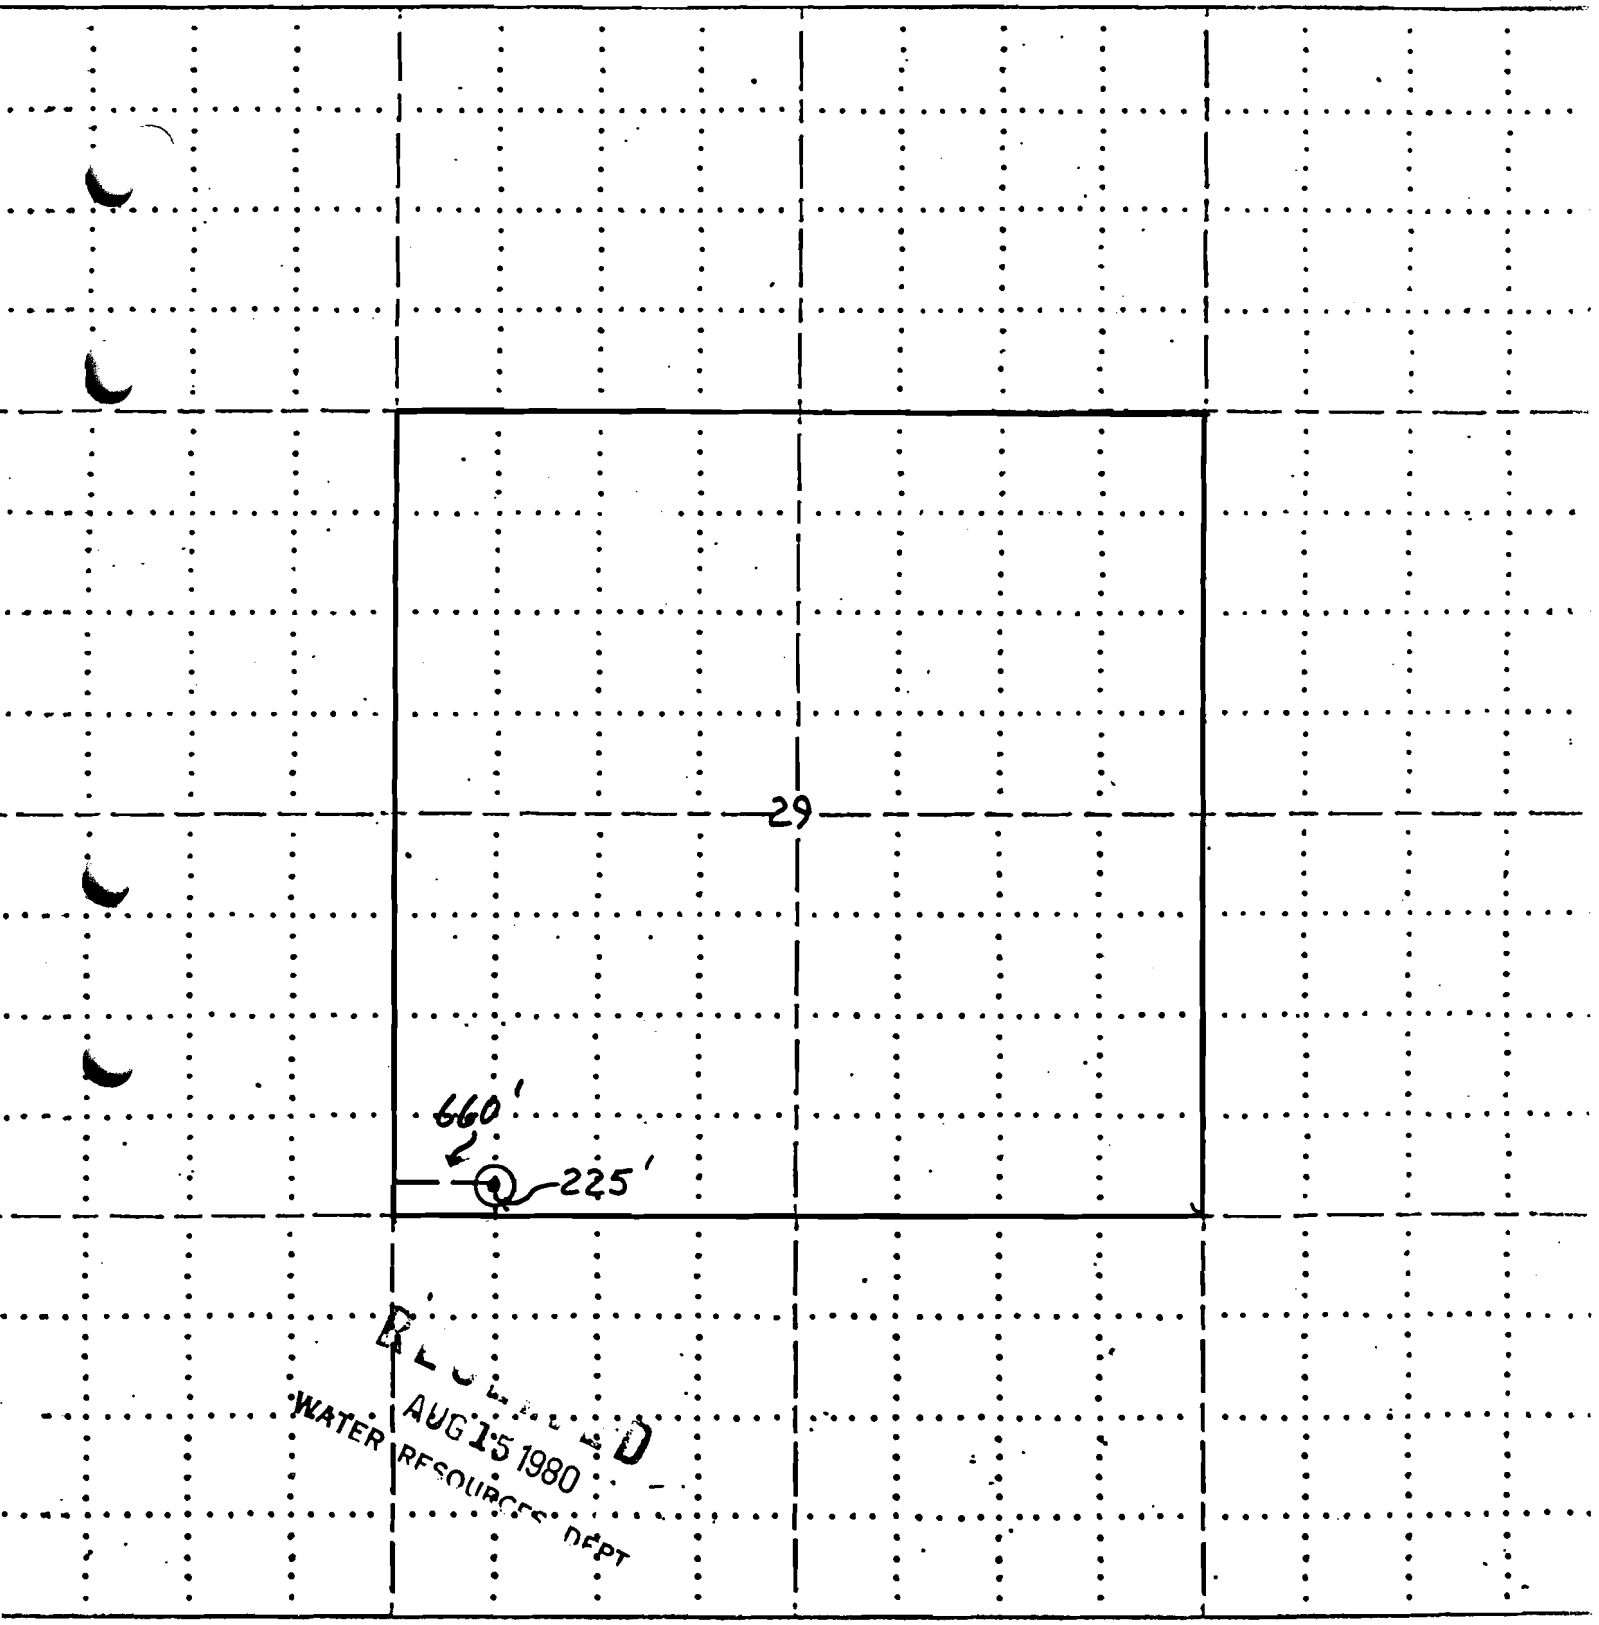

RECEIVED
AUG 15 1980
WATER RESOURCES DEPT

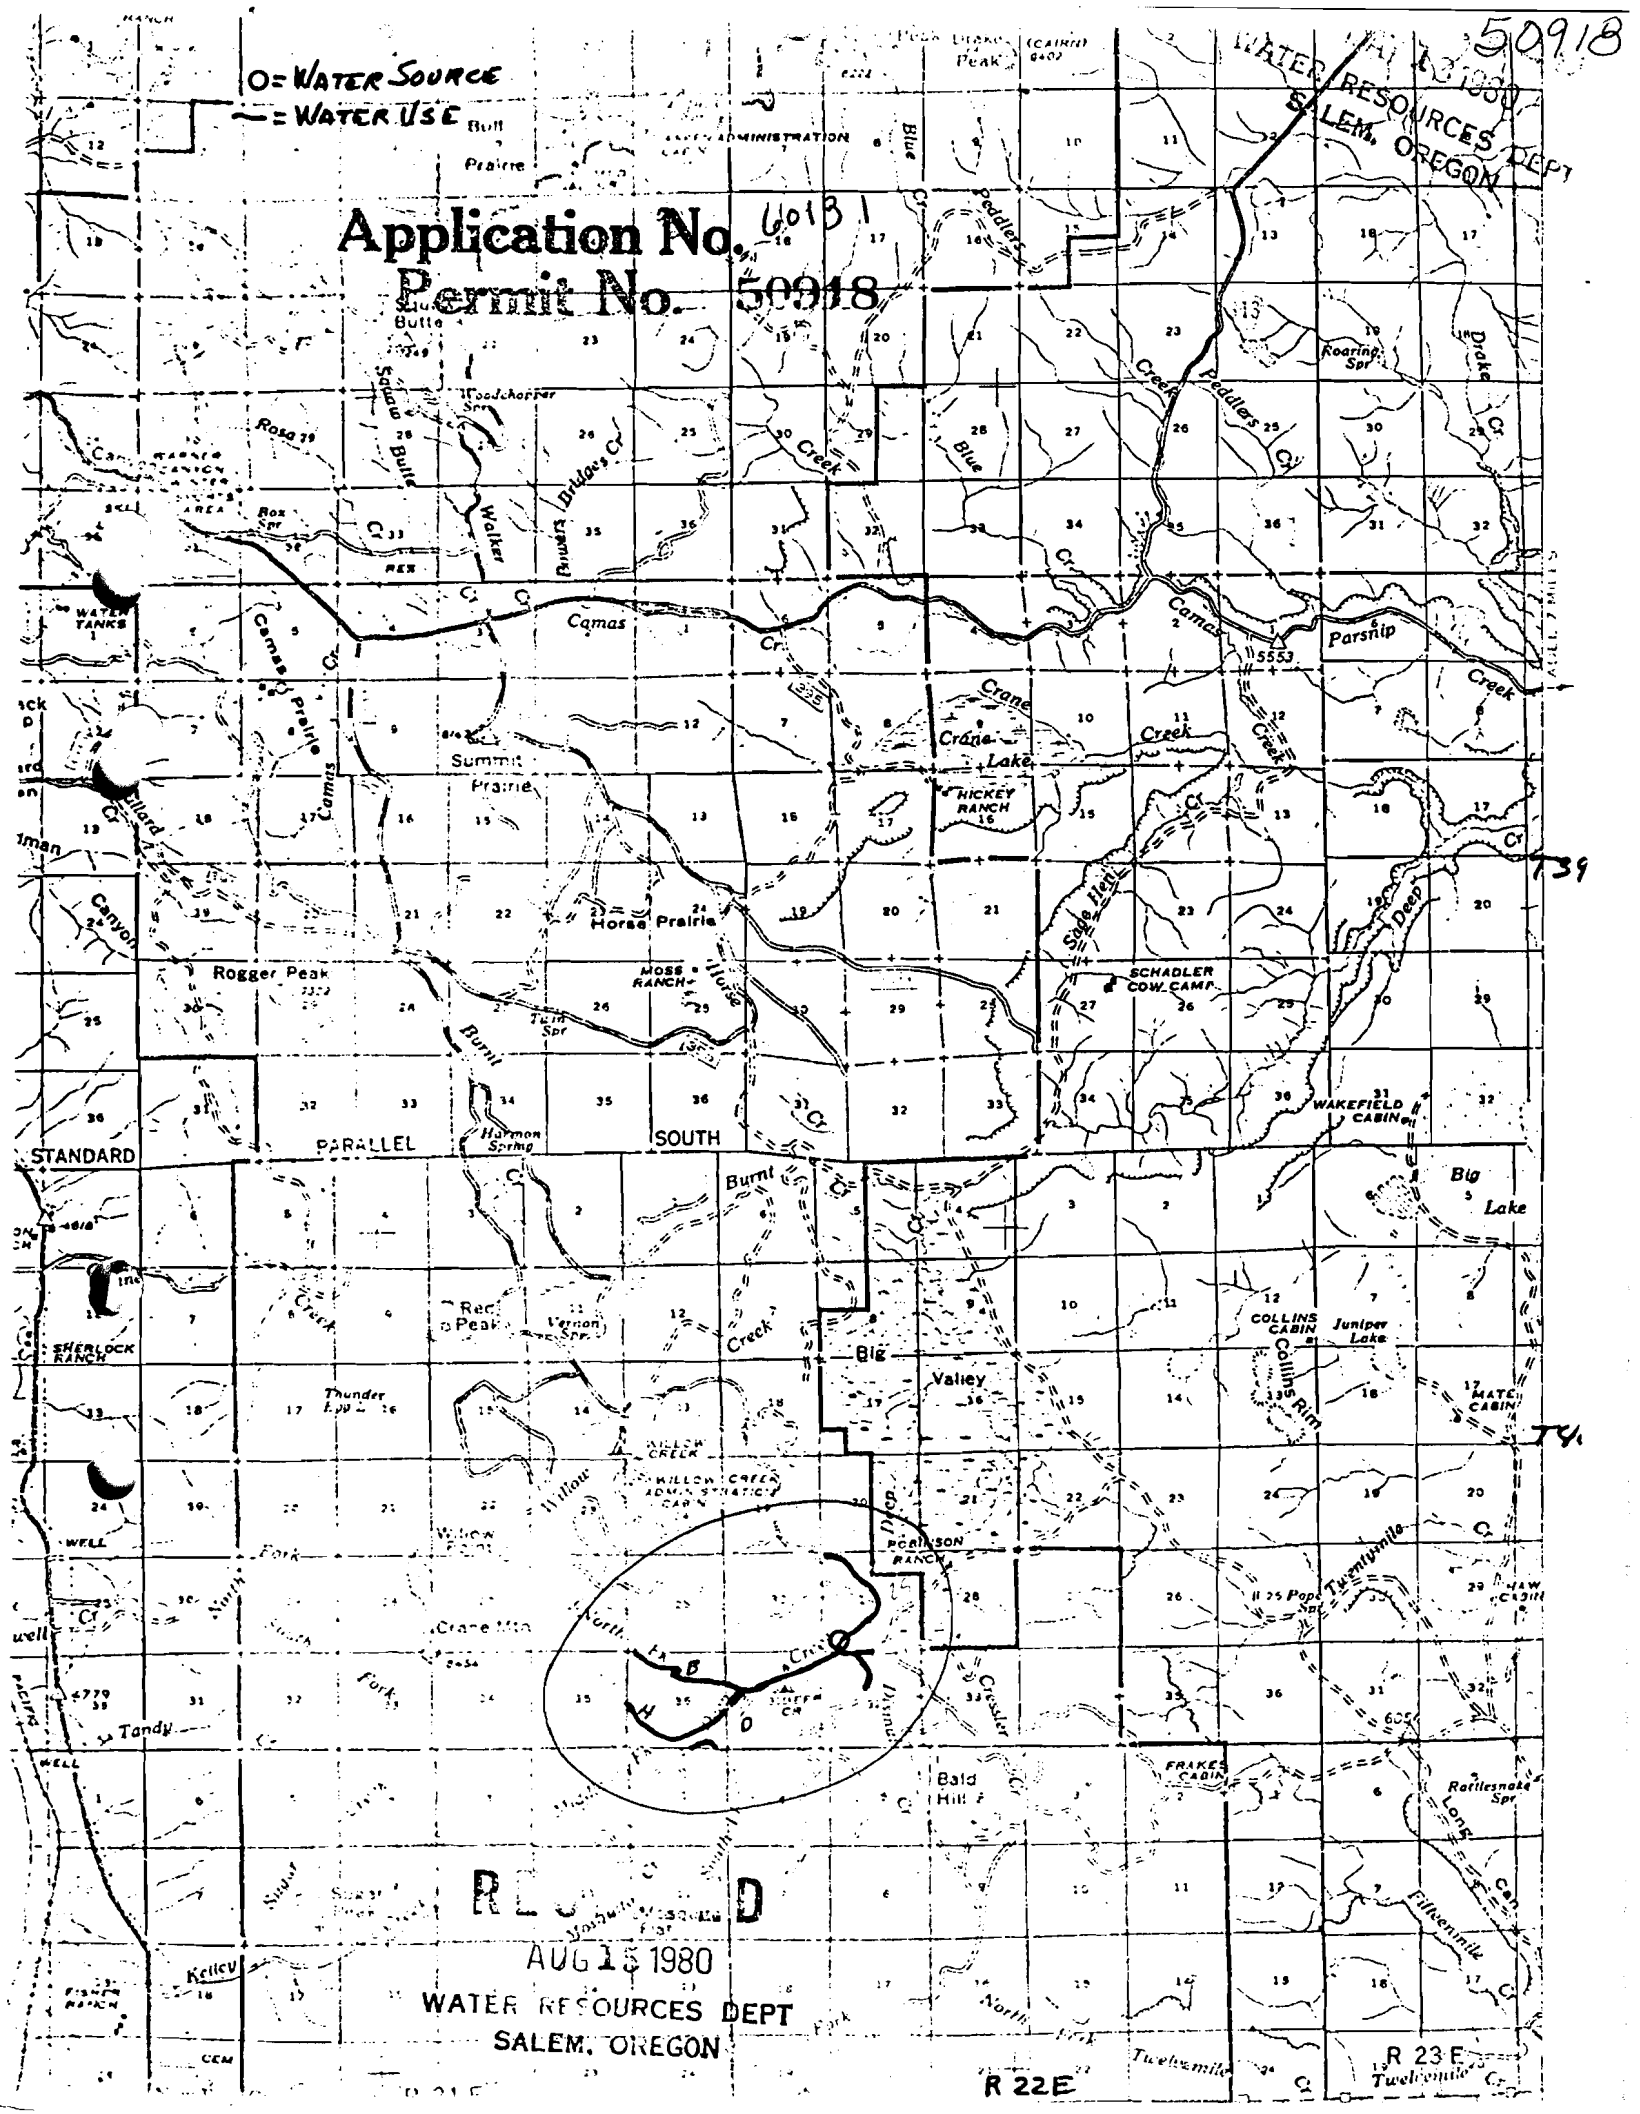
O = WATER SOURCE
— = WATER USE
Application No. 60181
Permit No. 50918
50918
WATER RESOURCES DEPT
SALEM, OREGON
RECEIVED
AUG 15 1980
WATER RESOURCES DEPT
SALEM, OREGON
R 22 E
R 23 E
T 39
T 4
Camas
Summit Prairie
Horse Prairie
Rogger Peak
Crane Lake
Crane Mtn
Big Valley
Bald Hill
Parsnip Creek
Burnt
STANDARD
PARALLEL
SOUTH
Blue
Peddlers Cr
Camas Prairie
Crane Creek
Deep
Big Lake
Juniper Lake
Twelvemile
Fifteenmile
Long
Rattlesnake Spr
Tandy
Kelley
SCHADLER COW CAMP
WAKEFIELD CABIN
COLLINS CABIN
Collins Rim
FRAKES CABIN
HICKEY RANCH
MOSS RANCH
ROBINSON RANCH
SHERLOCK RANCH
WATER TANKS
5553