

KL

50884

FIELD MAP SHEET

APR 11 1944

66190

T. 36 S R. 18 E Sec. 6 Subdiv. SW 1/4, SW 1/4

WATER RESOURCES DEPT
SALEM OREGON N.F.
FARM

APPLICATION NO. 59961


Scale 8.2 inches = 1 Mile

PERMIT NO. _____

Application No. 59961
Permit No. 50884

⊙ = WATER SOURCE

NORTH

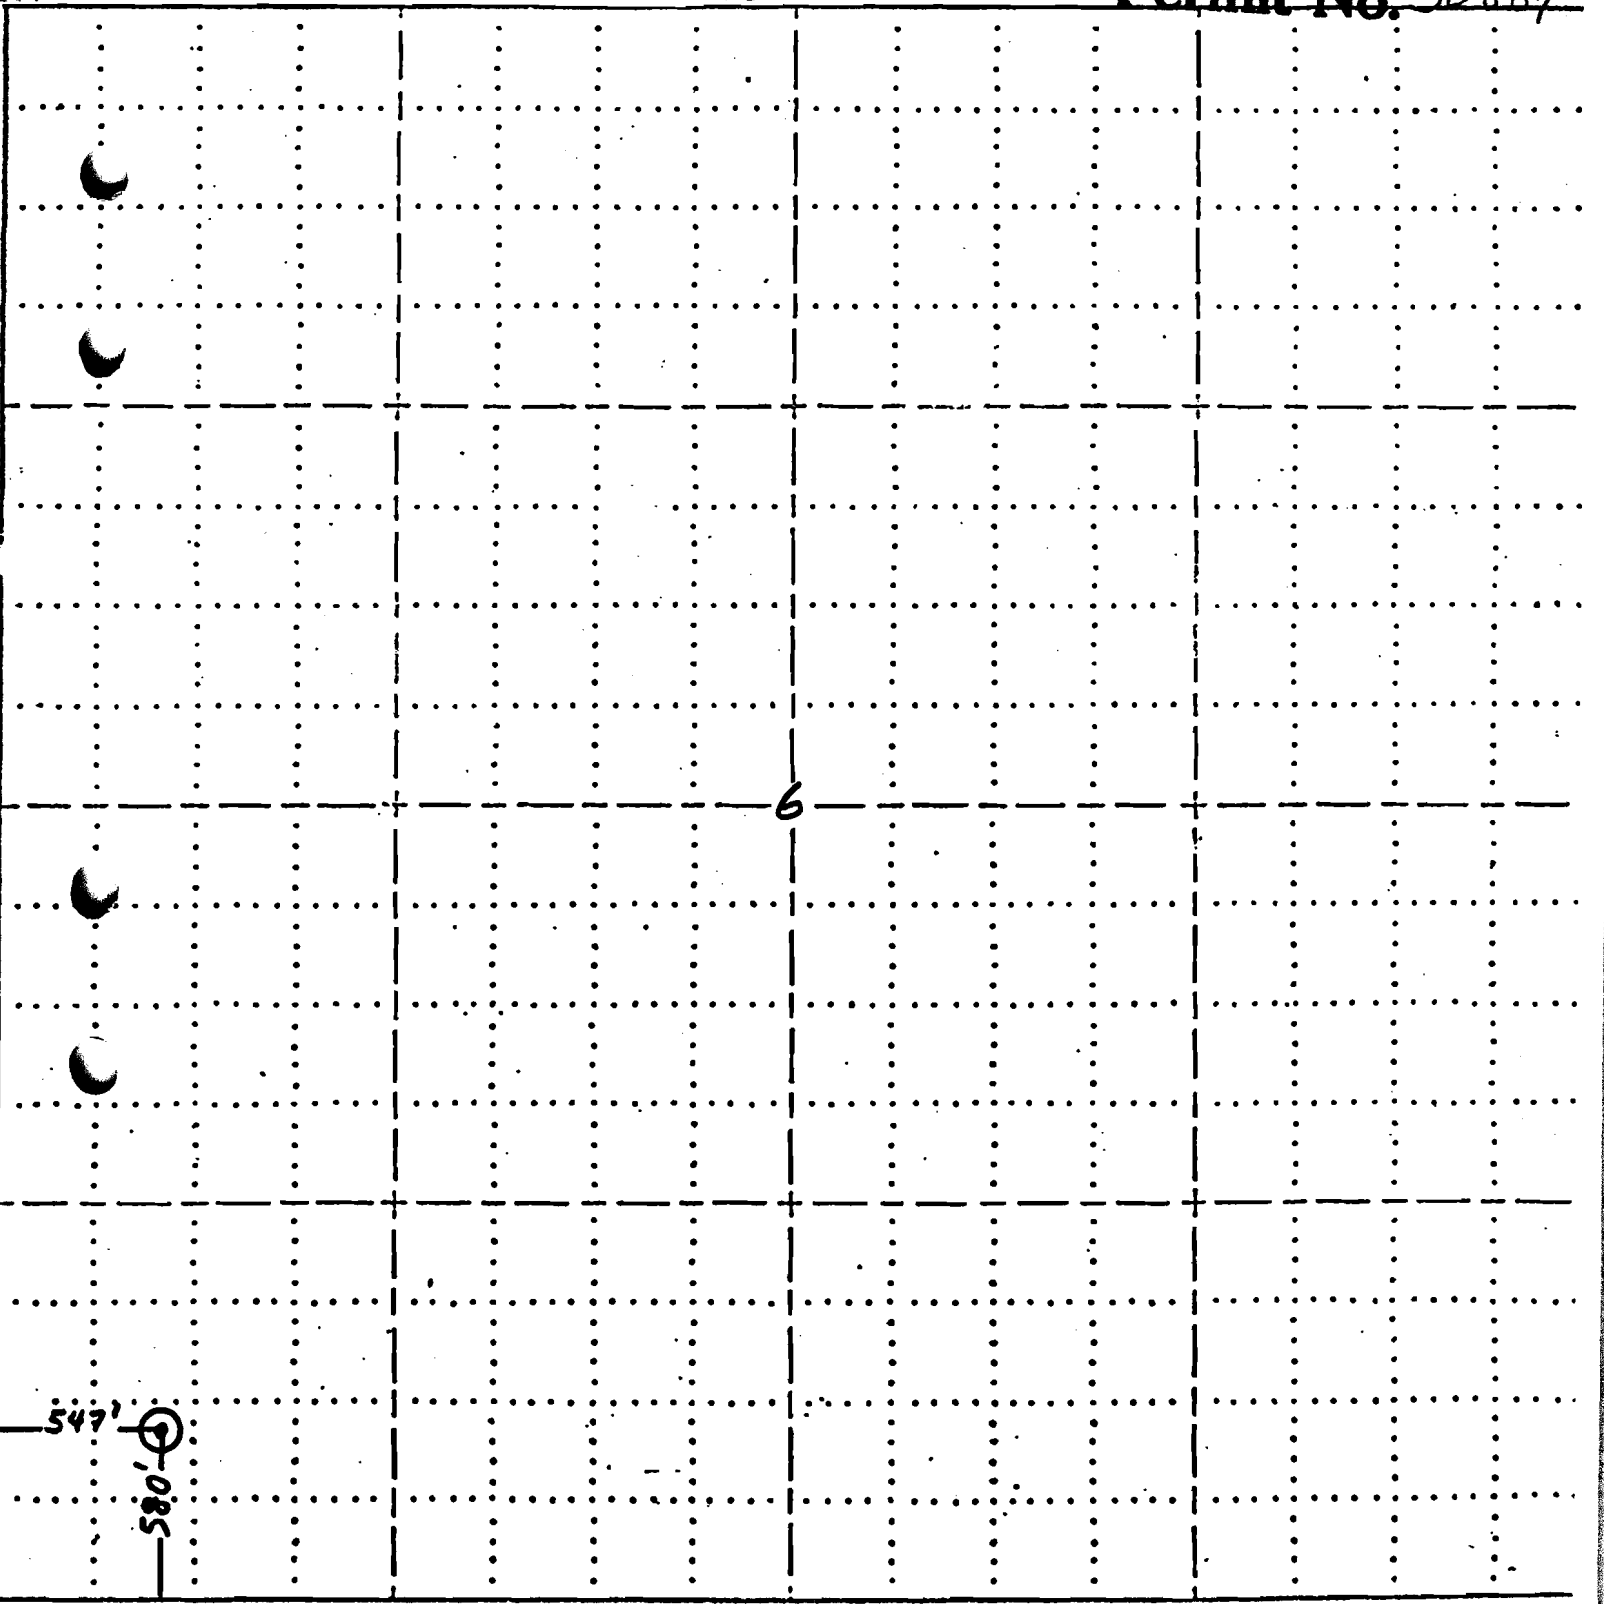

547' ⊙
580'