

50911
66196

FIELD MAP SHEET

T. 37S R. 20E Sec. 6 Subdiv. SE¹/₄-SE¹/₄ FREMONT, OREGON N.F.

Scale 8.2 inches = 1 Mile

APPLICATION NO. _____


PERMIT NO. _____

⊙ = WATER SOURCE

Application No. 59992

Permit No. 50911

NORTH

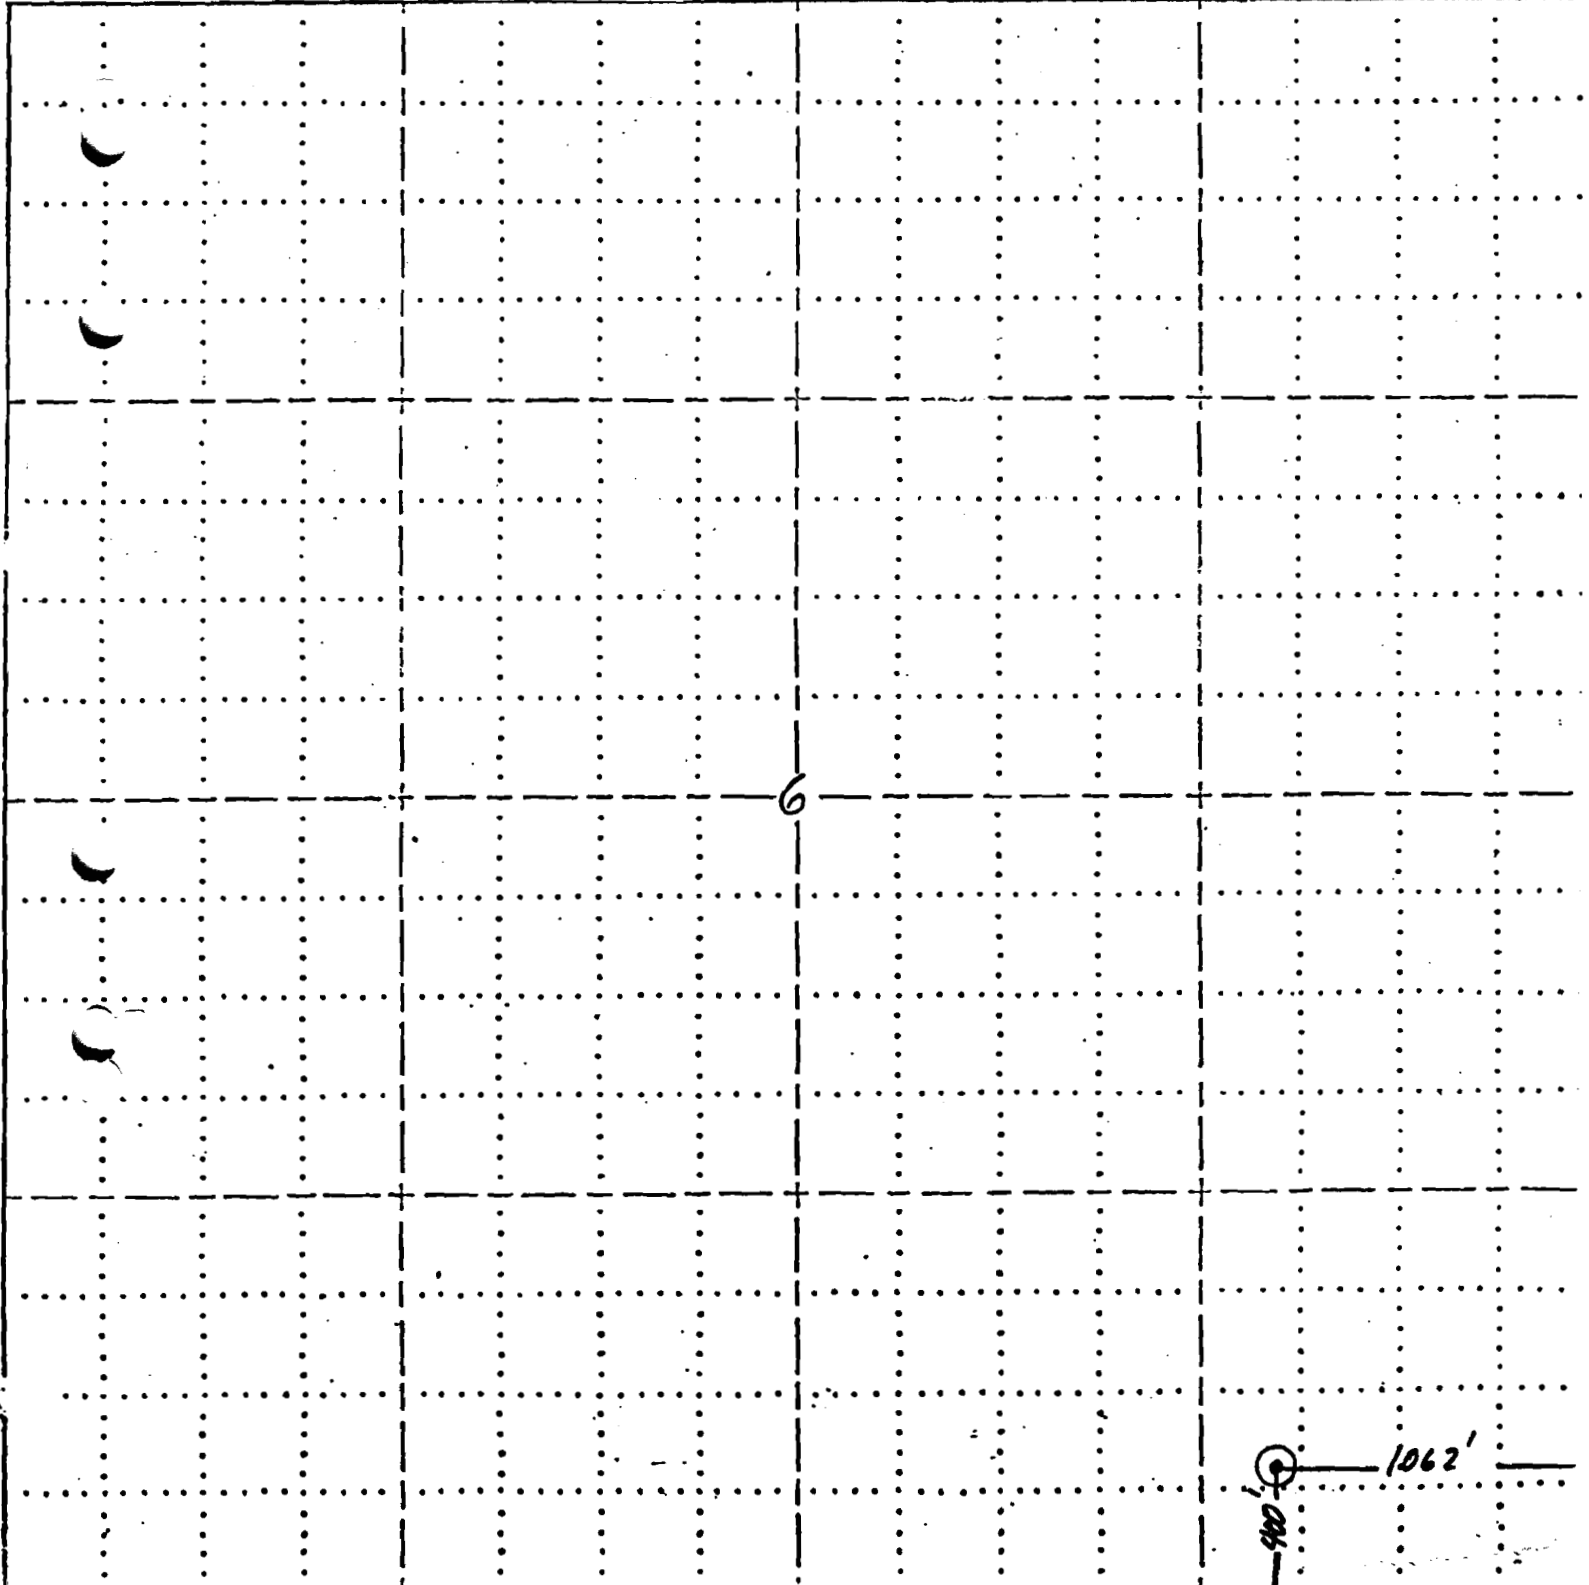


⊙ — 1062'

WATER USE

R19E

R20E

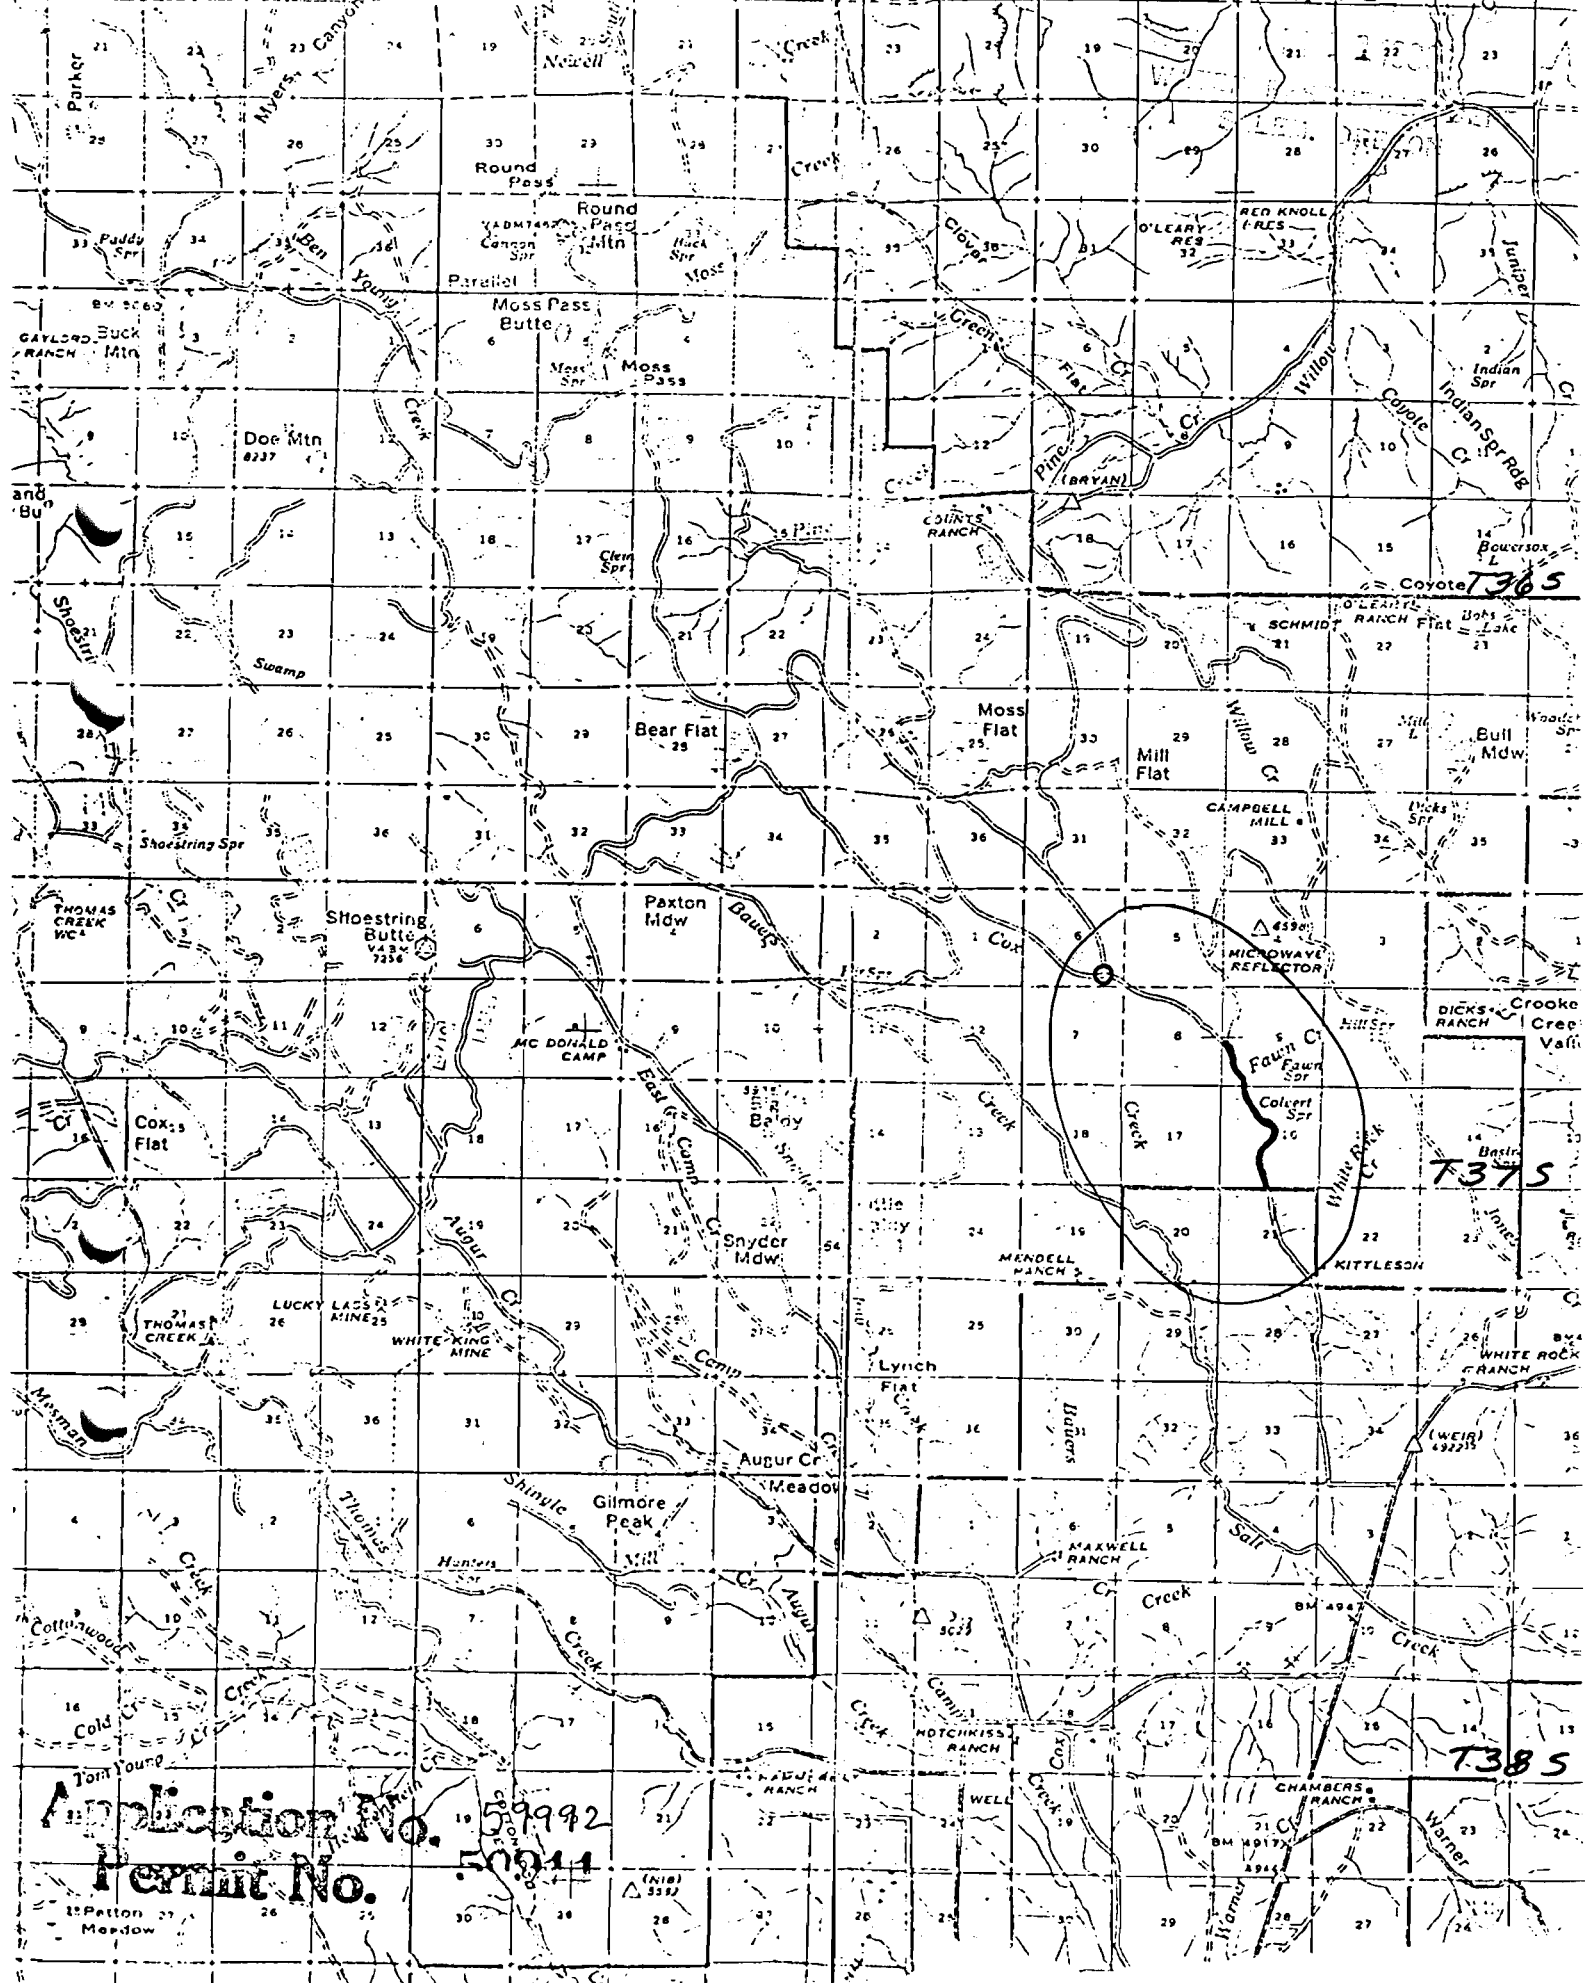

Application No. 59992
 Permit No. 50911

T365

T375

T385

(111) 5392