

FIELD MAP SHEET

50896  
66199  
10/2  
MAY 21 1980  
WATER RESOURCES DEPT  
SALEM, OREGON


T. 41S R. 16E Sec. 7 Subdiv. NW 1/4-NE 1/4 FREMONT NE

APPLICATION NO. 59981  
PERMIT NO. \_\_\_\_\_  
⊙ = WATER SOURCE

Scale 8.2 inches = 1 Mile


Application No. 59981  
Permit No. 50896

NORTH

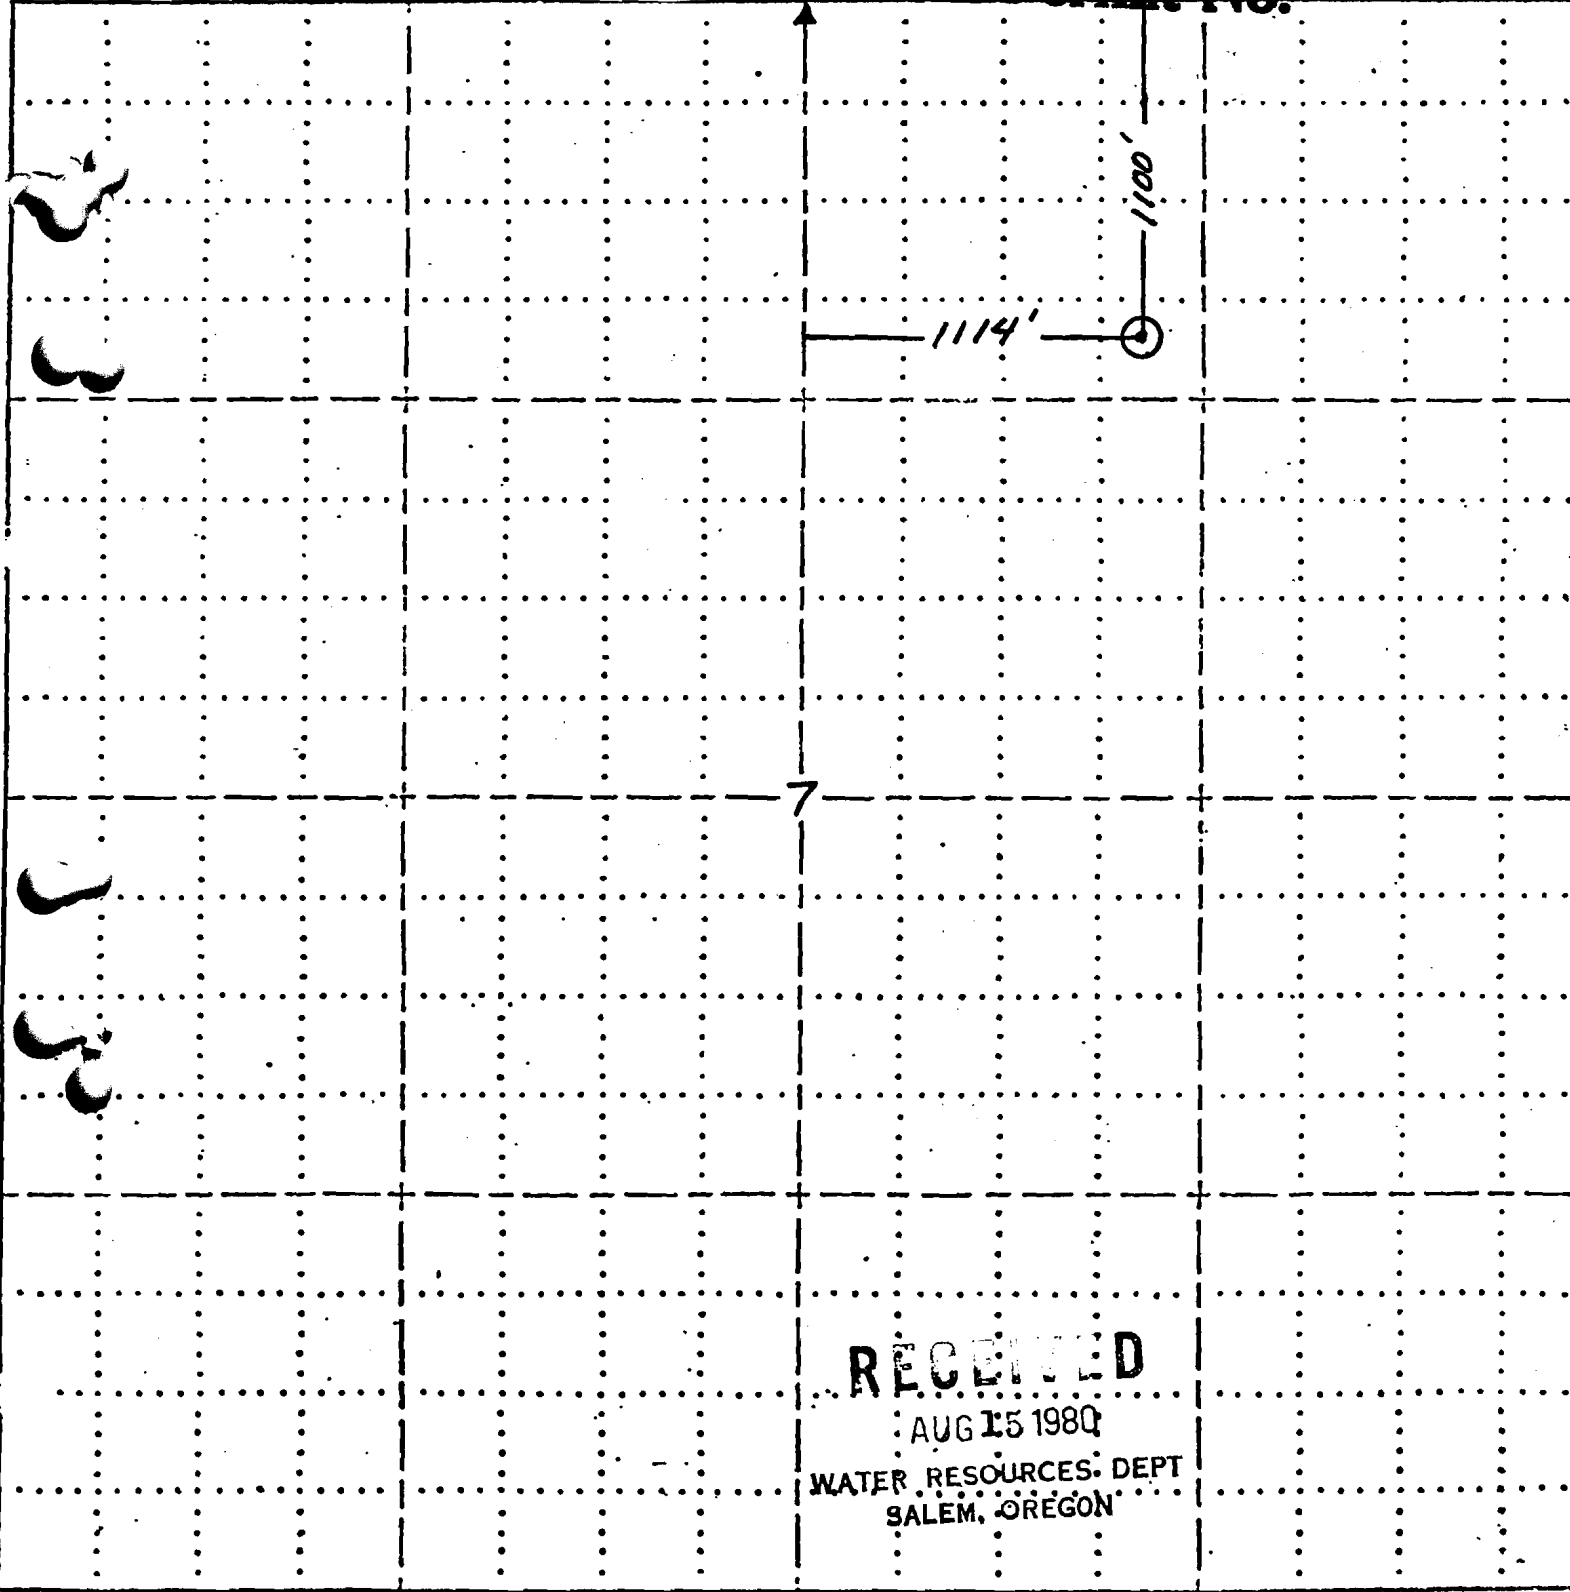

RECEIVED  
AUG 15 1980  
WATER RESOURCES DEPT  
SALEM, OREGON

Willow Ck. & Misc.

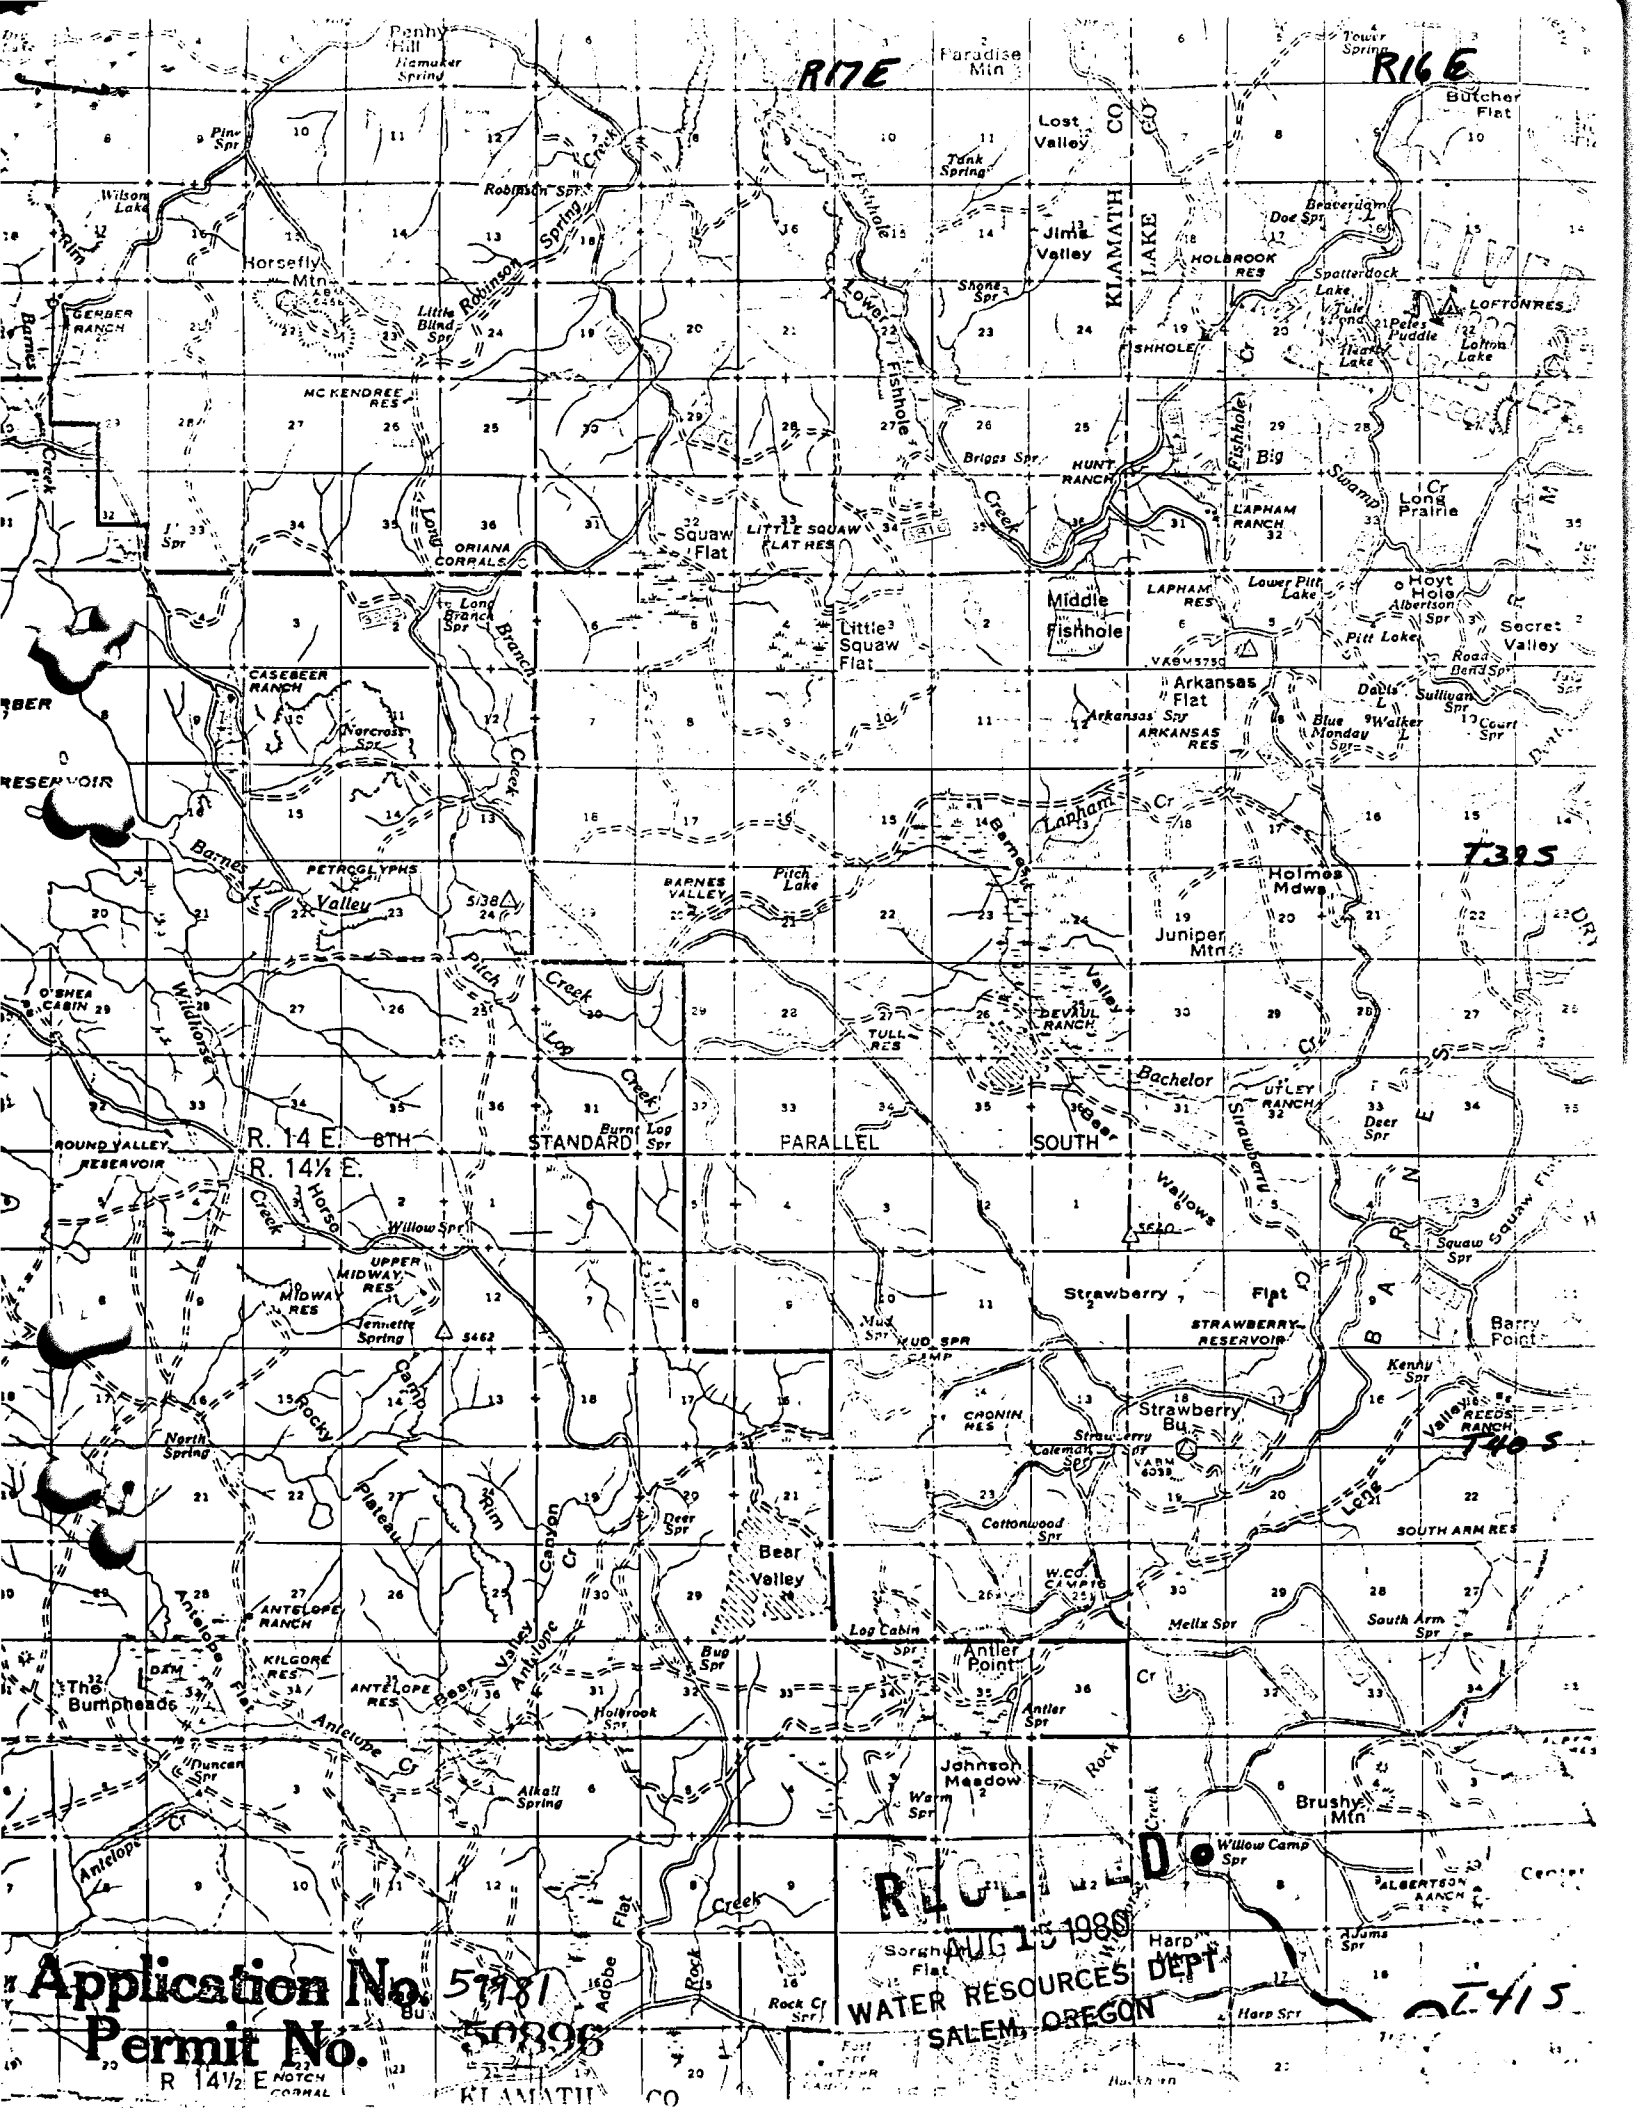

R17E

R16E



 Permit No. 50896

AUG 13 1980  
 WATER RESOURCES DEPT  
 SALEM, OREGON

