

50889
66202

FIELD MAP SHEET

APR 11 1950
WATER RESOURCES DEPT.
SULLY, OREGON

T. 35s R. 17E Sec. 12 Subdiv. NW 1/4, SE 1/4

FREMONT

APPLICATION NO. 59969

Scale 8.2 inches = 1 Mile


PERMIT NO. _____

Application No. 59969

⊙ = WATER SOURCE

NORTH


Permit No. _____

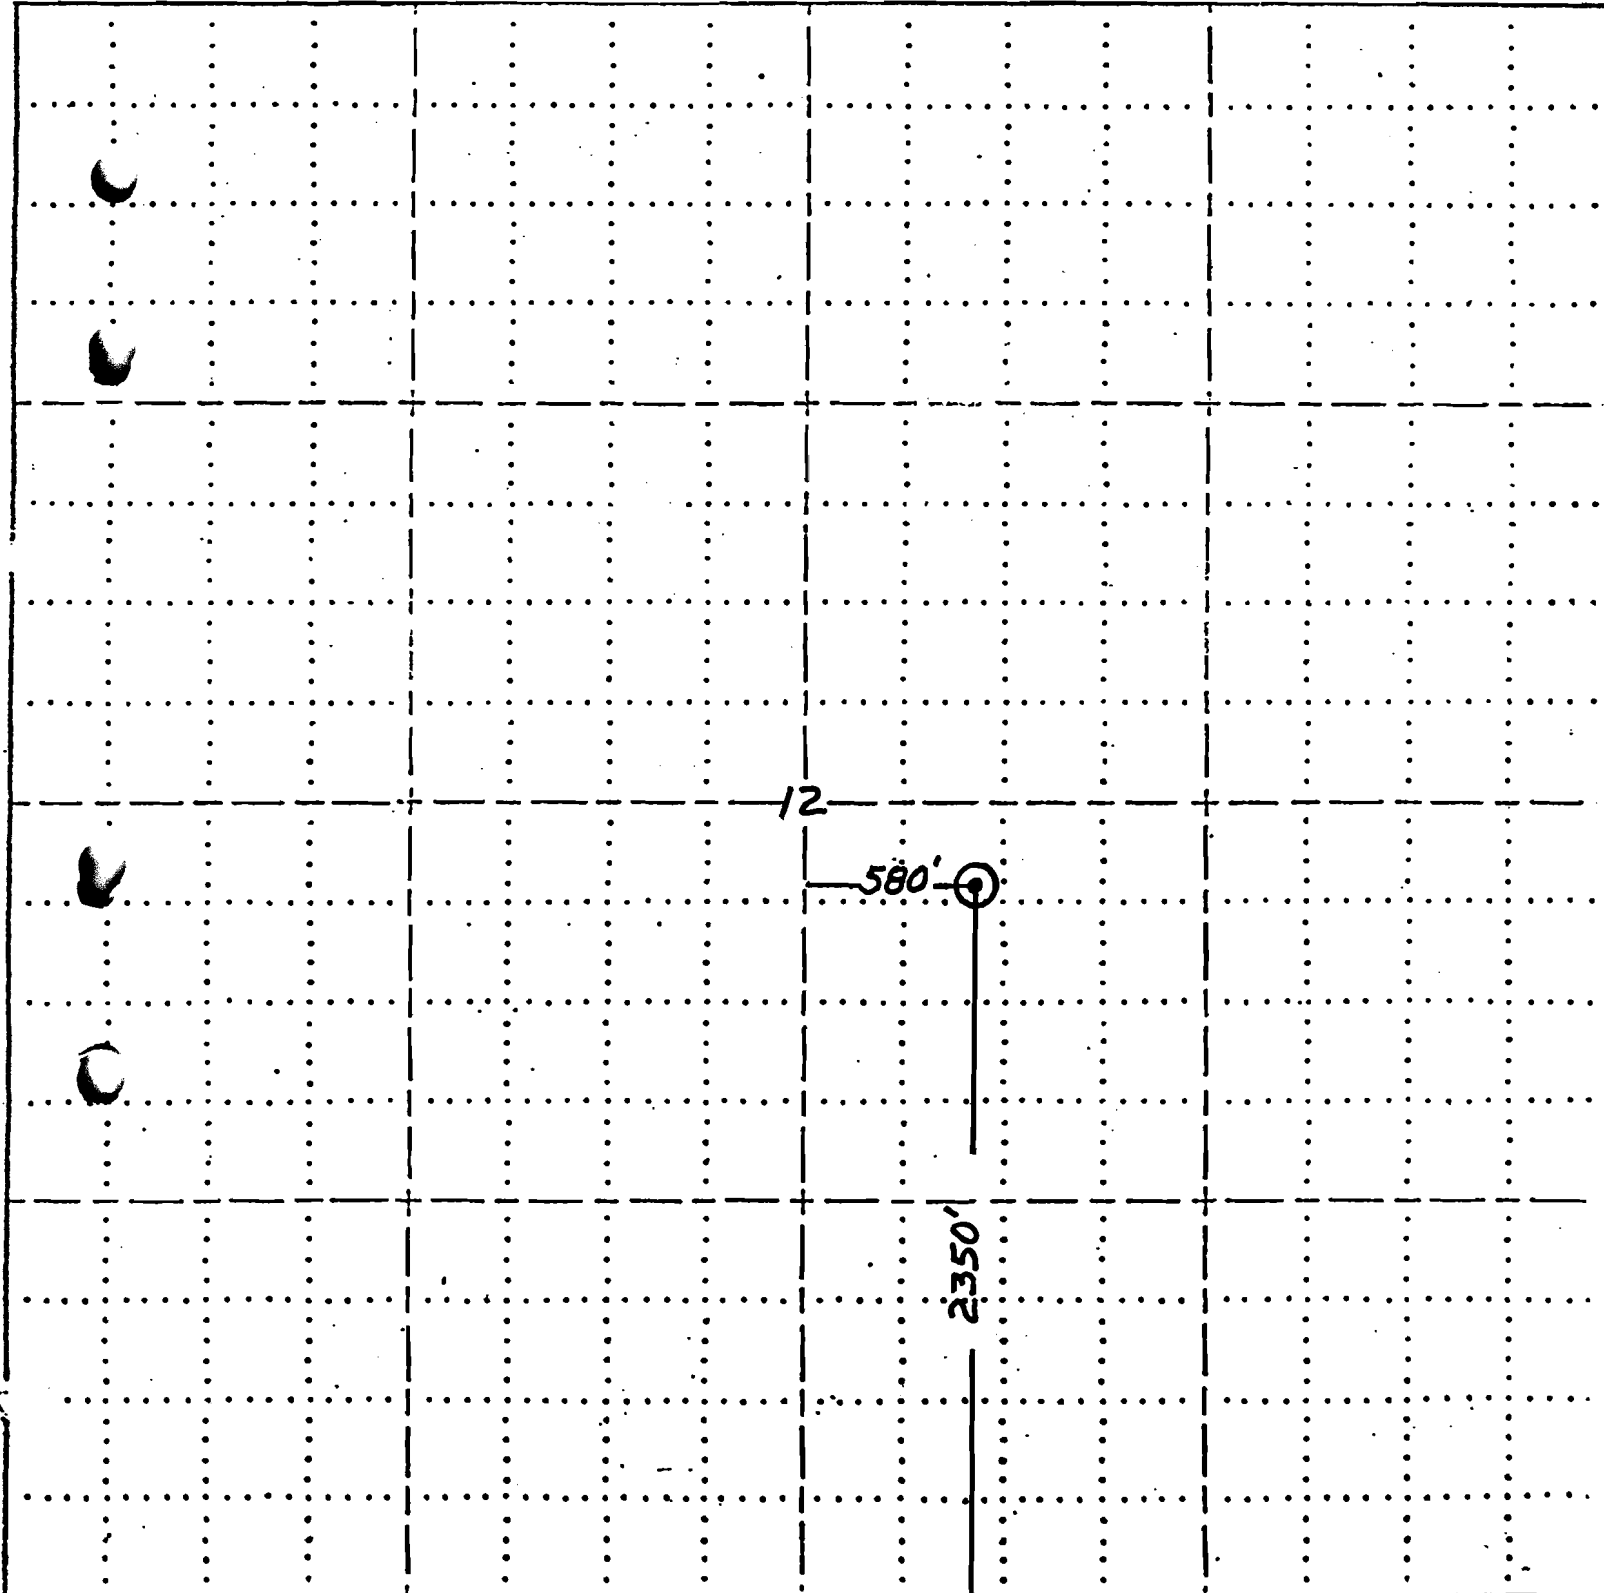

R17E

R18E

O = WATER SOURCE
 ~ ~ = WATER USE
 #50889

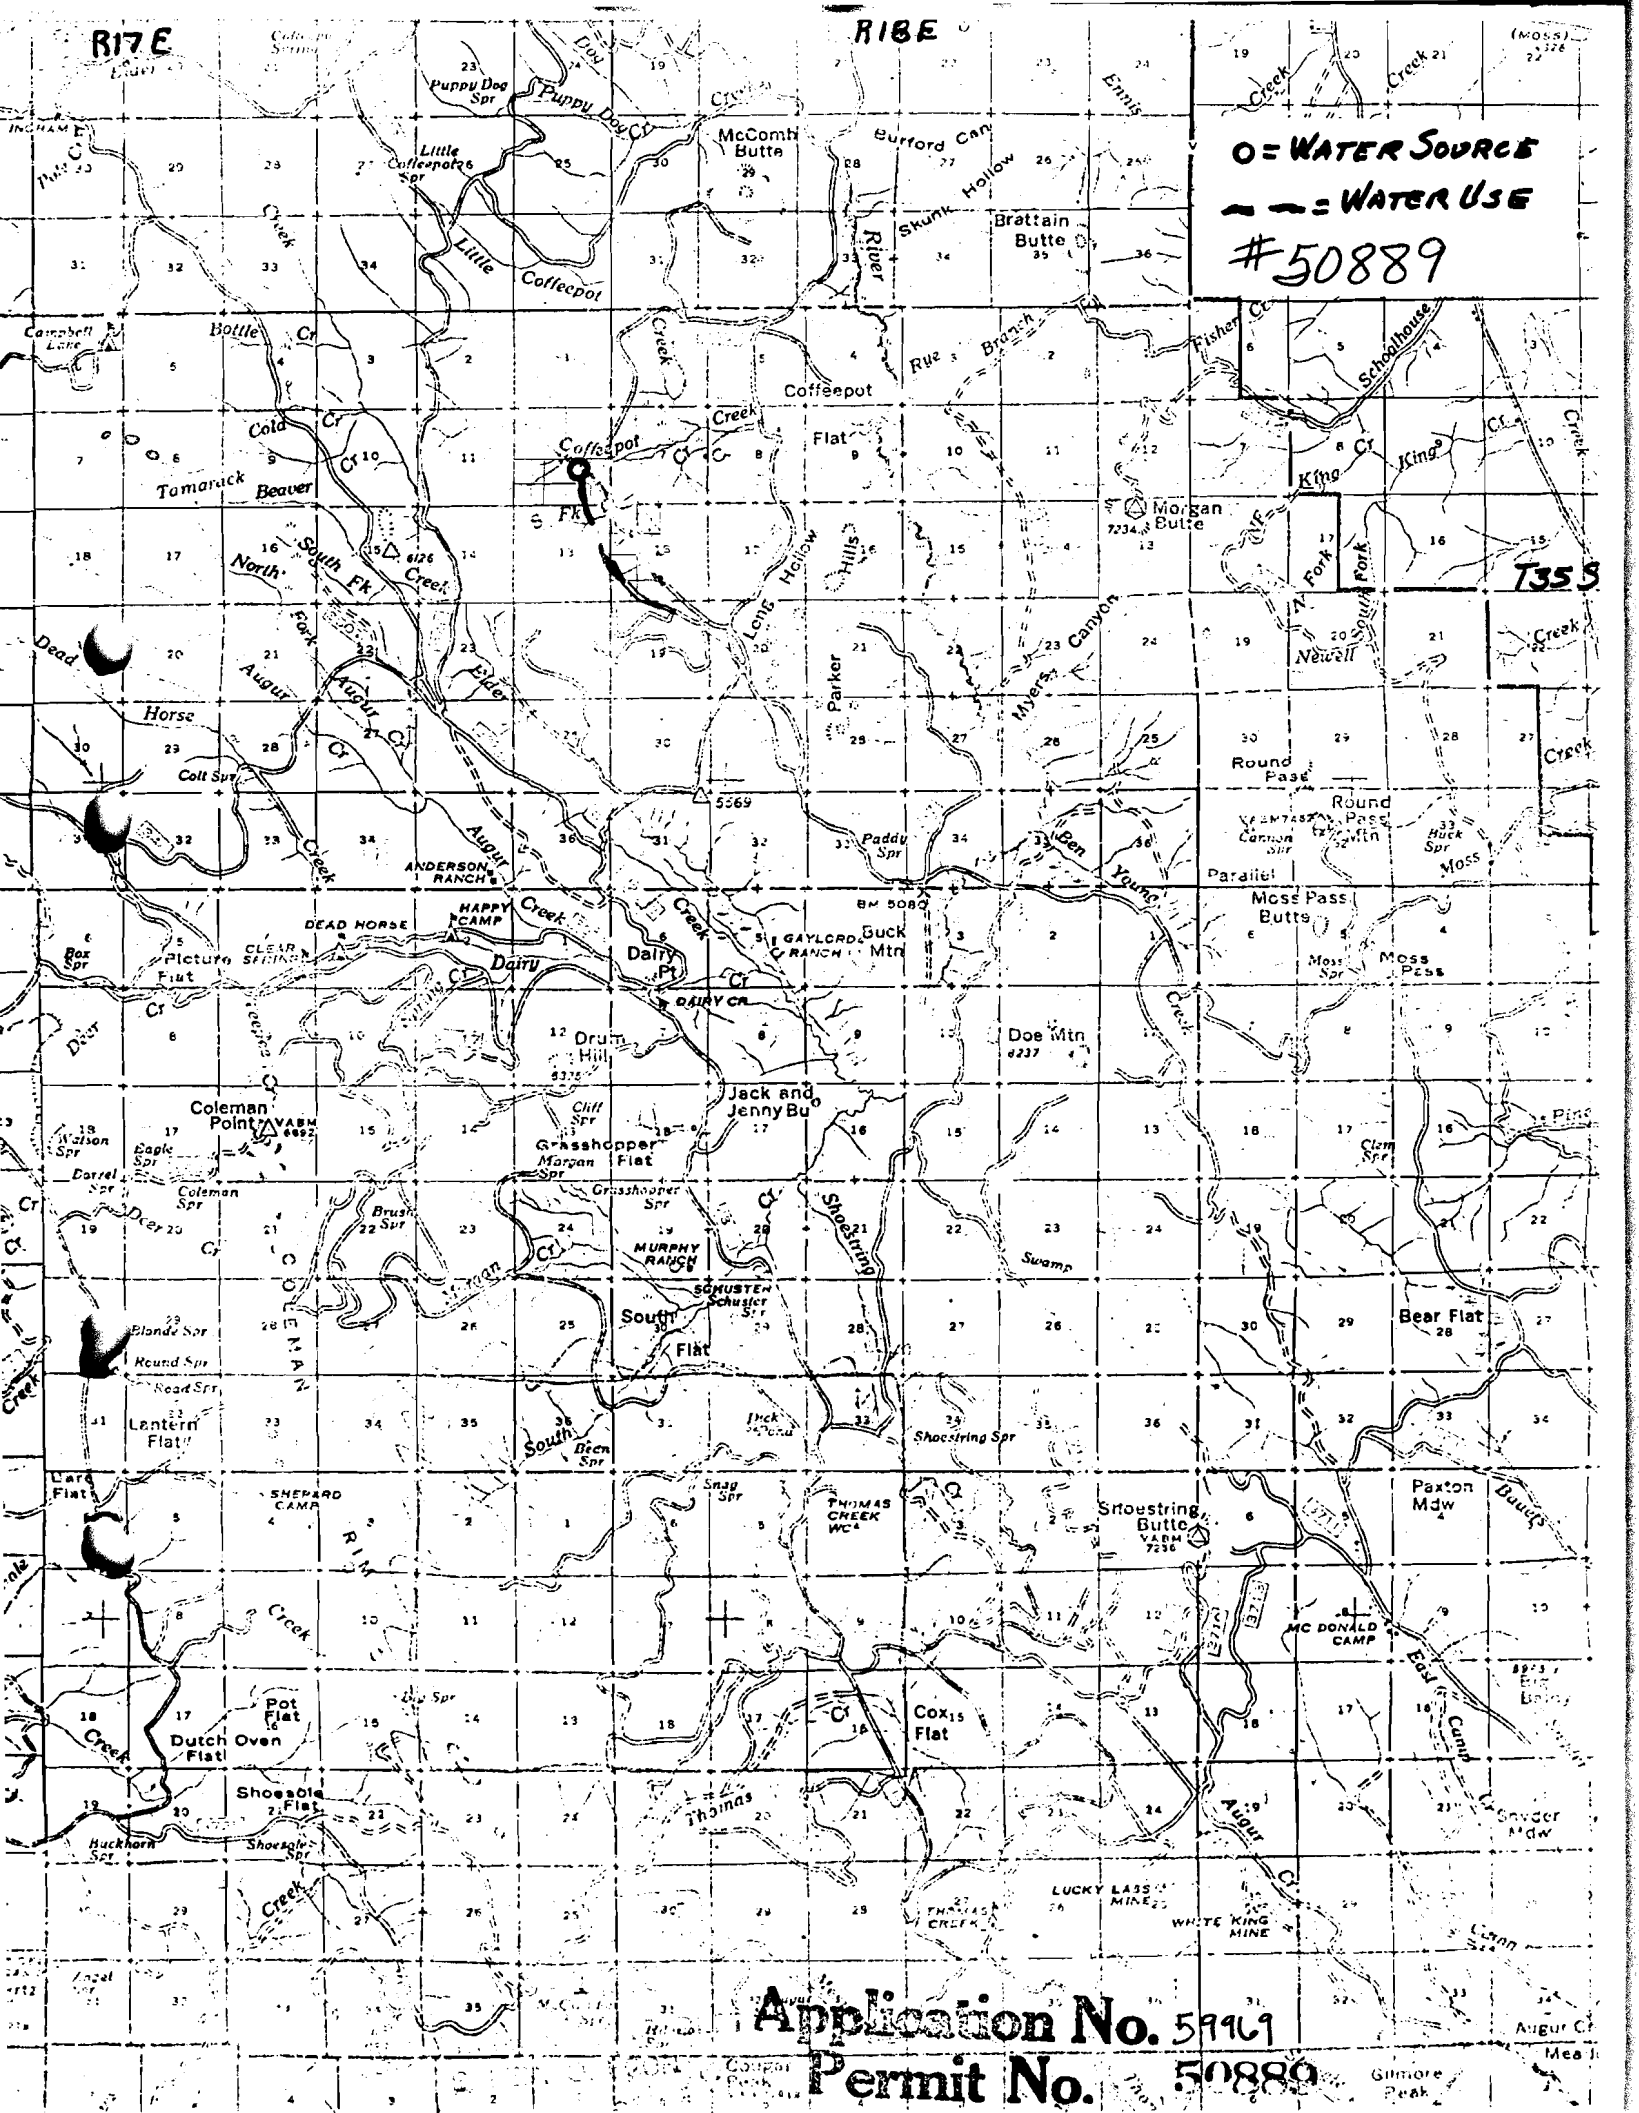

Application No. 59969
 Permit No. 50889