

50890
66209

FIELD MAP SHEET

FILE 11800
WATER RESOURCES DEPT
SALEM, OREGON

T. 36S R. 18E Sec. 20 Subdiv. NE 1/4-SW 1/4 FREMONT N.E.

Scale 8.2 inches = 1 Mile

APPLICATION NO. _____

PERMIT NO. _____

⊙ = WATER SOURCE

Application No. 51999

Permit No. 50890

NORTH

20


821'

802'

RECORDED

AUG 15 1980

WATER RESOURCES DEPT.
SALEM, OREGON

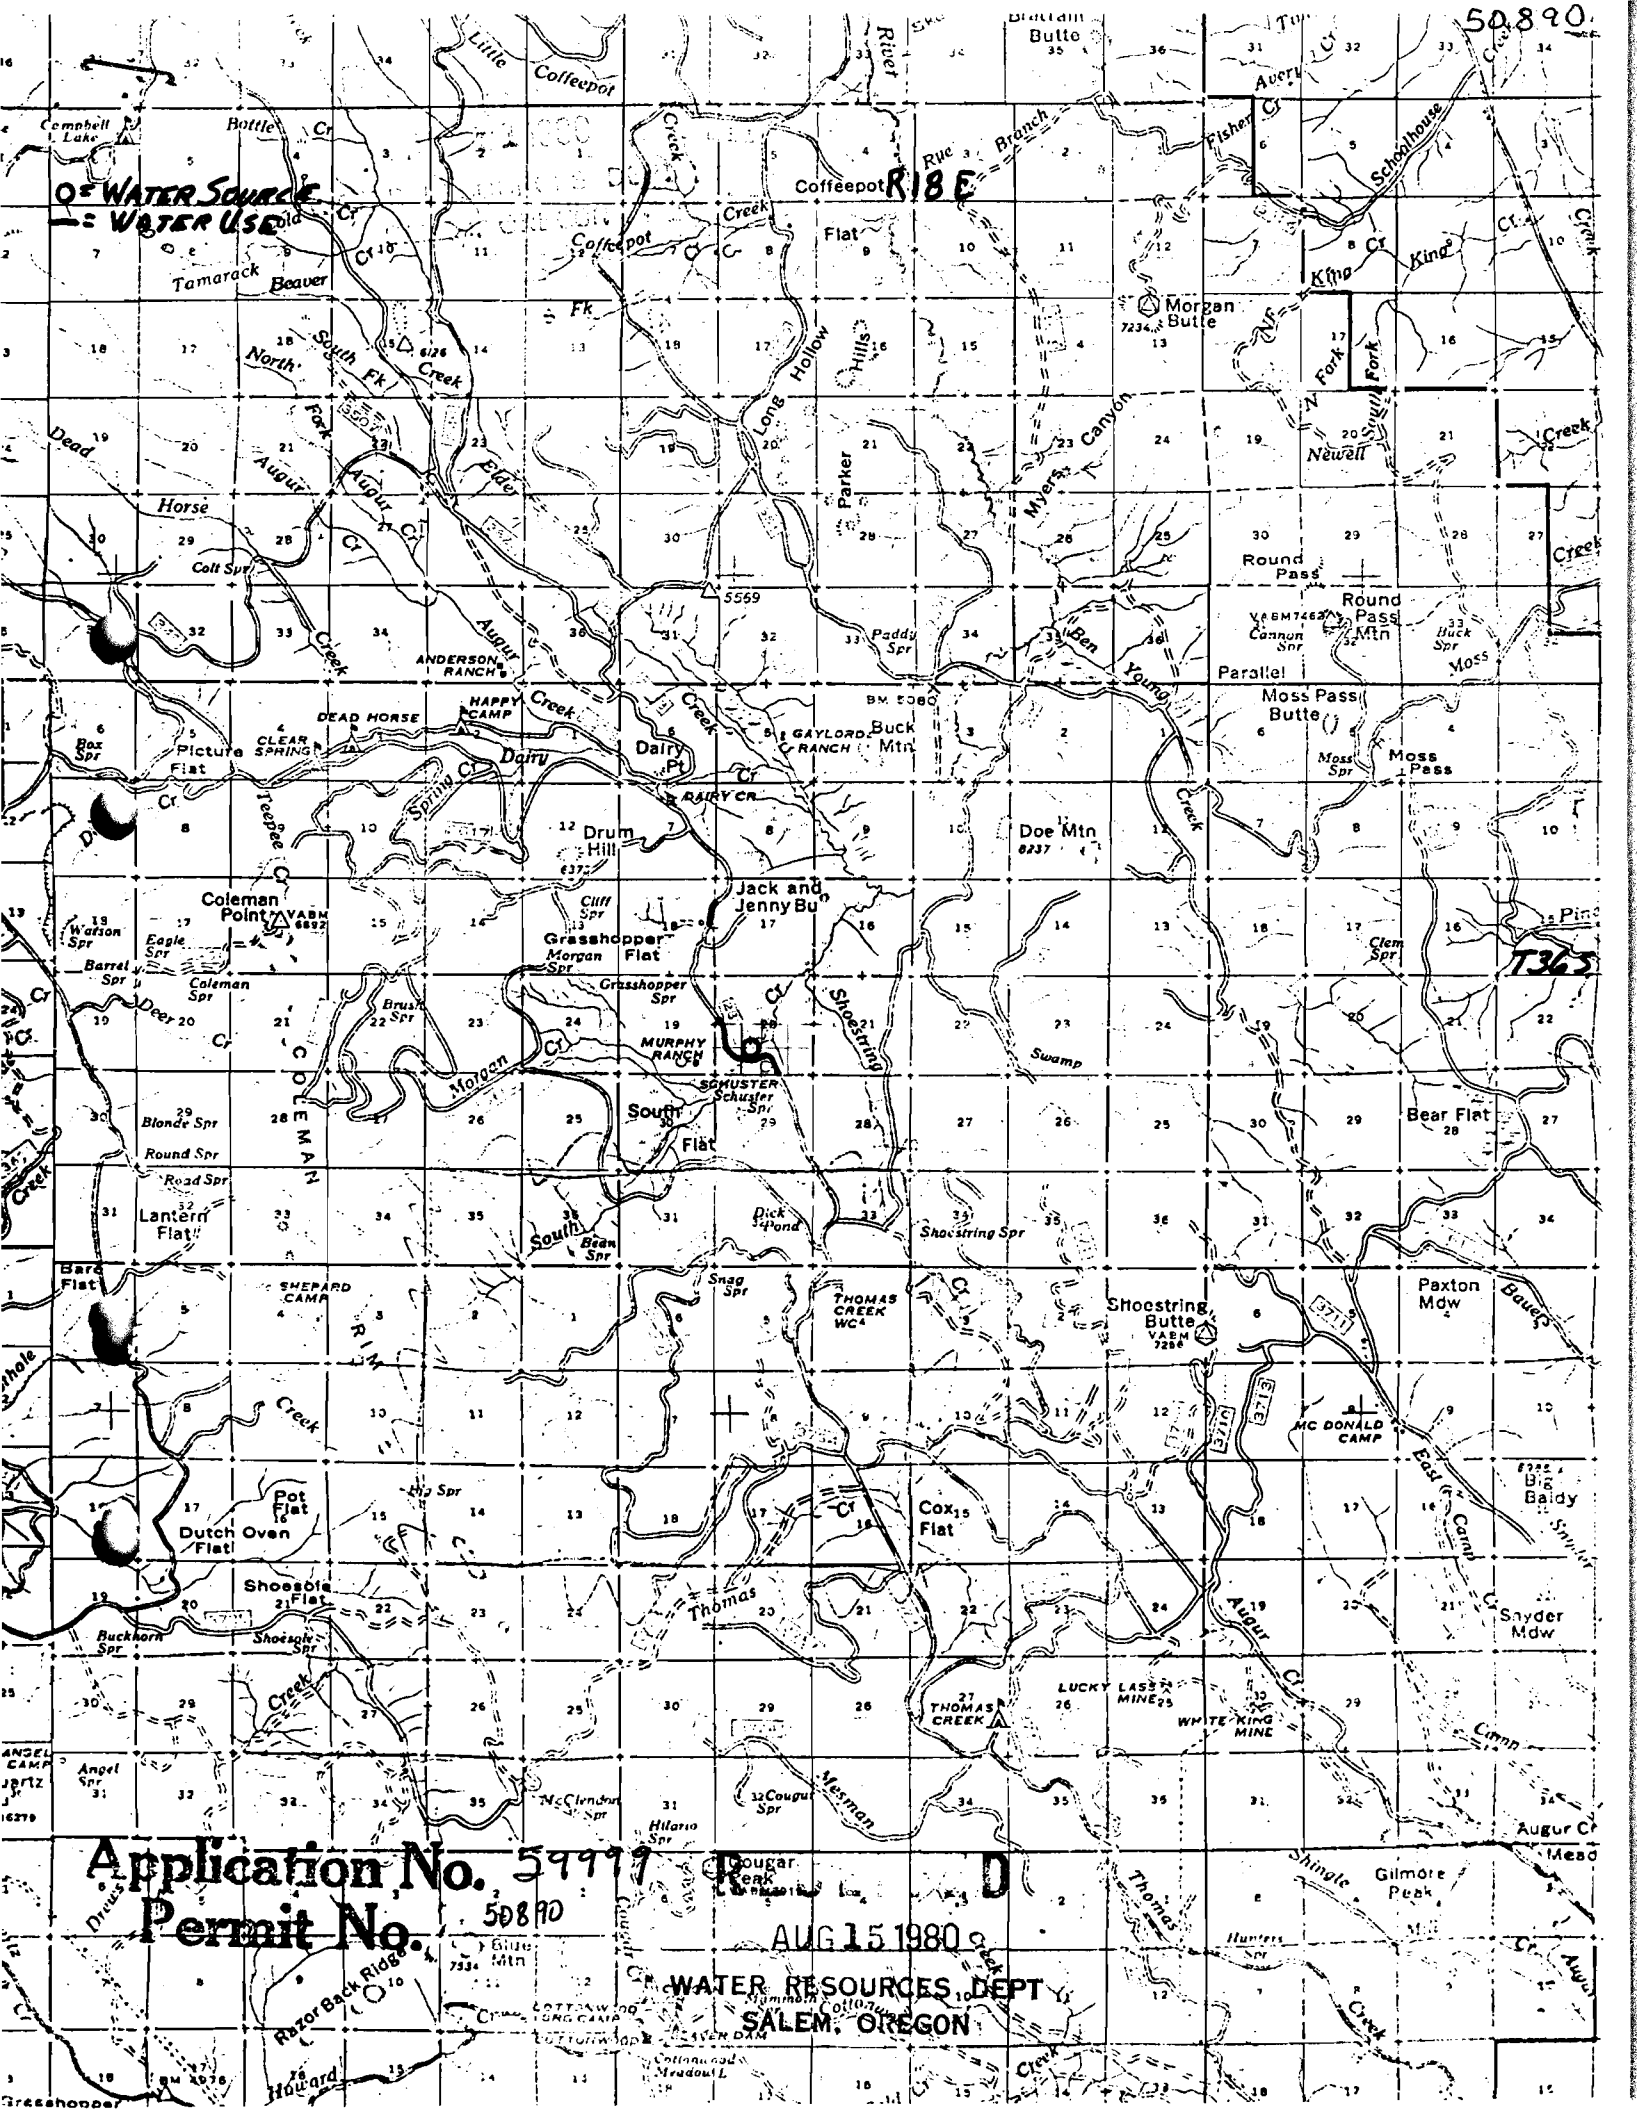

O= WATER SOURCE
W= WATER USED

RIBE

T363

Application No. 59917
Permit No. 50890

AUG 15 1980

WATER RESOURCES DEPT
SALEM, OREGON