


SECTION

7 SE NW
6 NW SE

10-5441 Horse Canyon #4
10-5442 Horse Canyon #5

TOWNSHIP 34 **S**, RANGE 26 **E**, W. M.

North

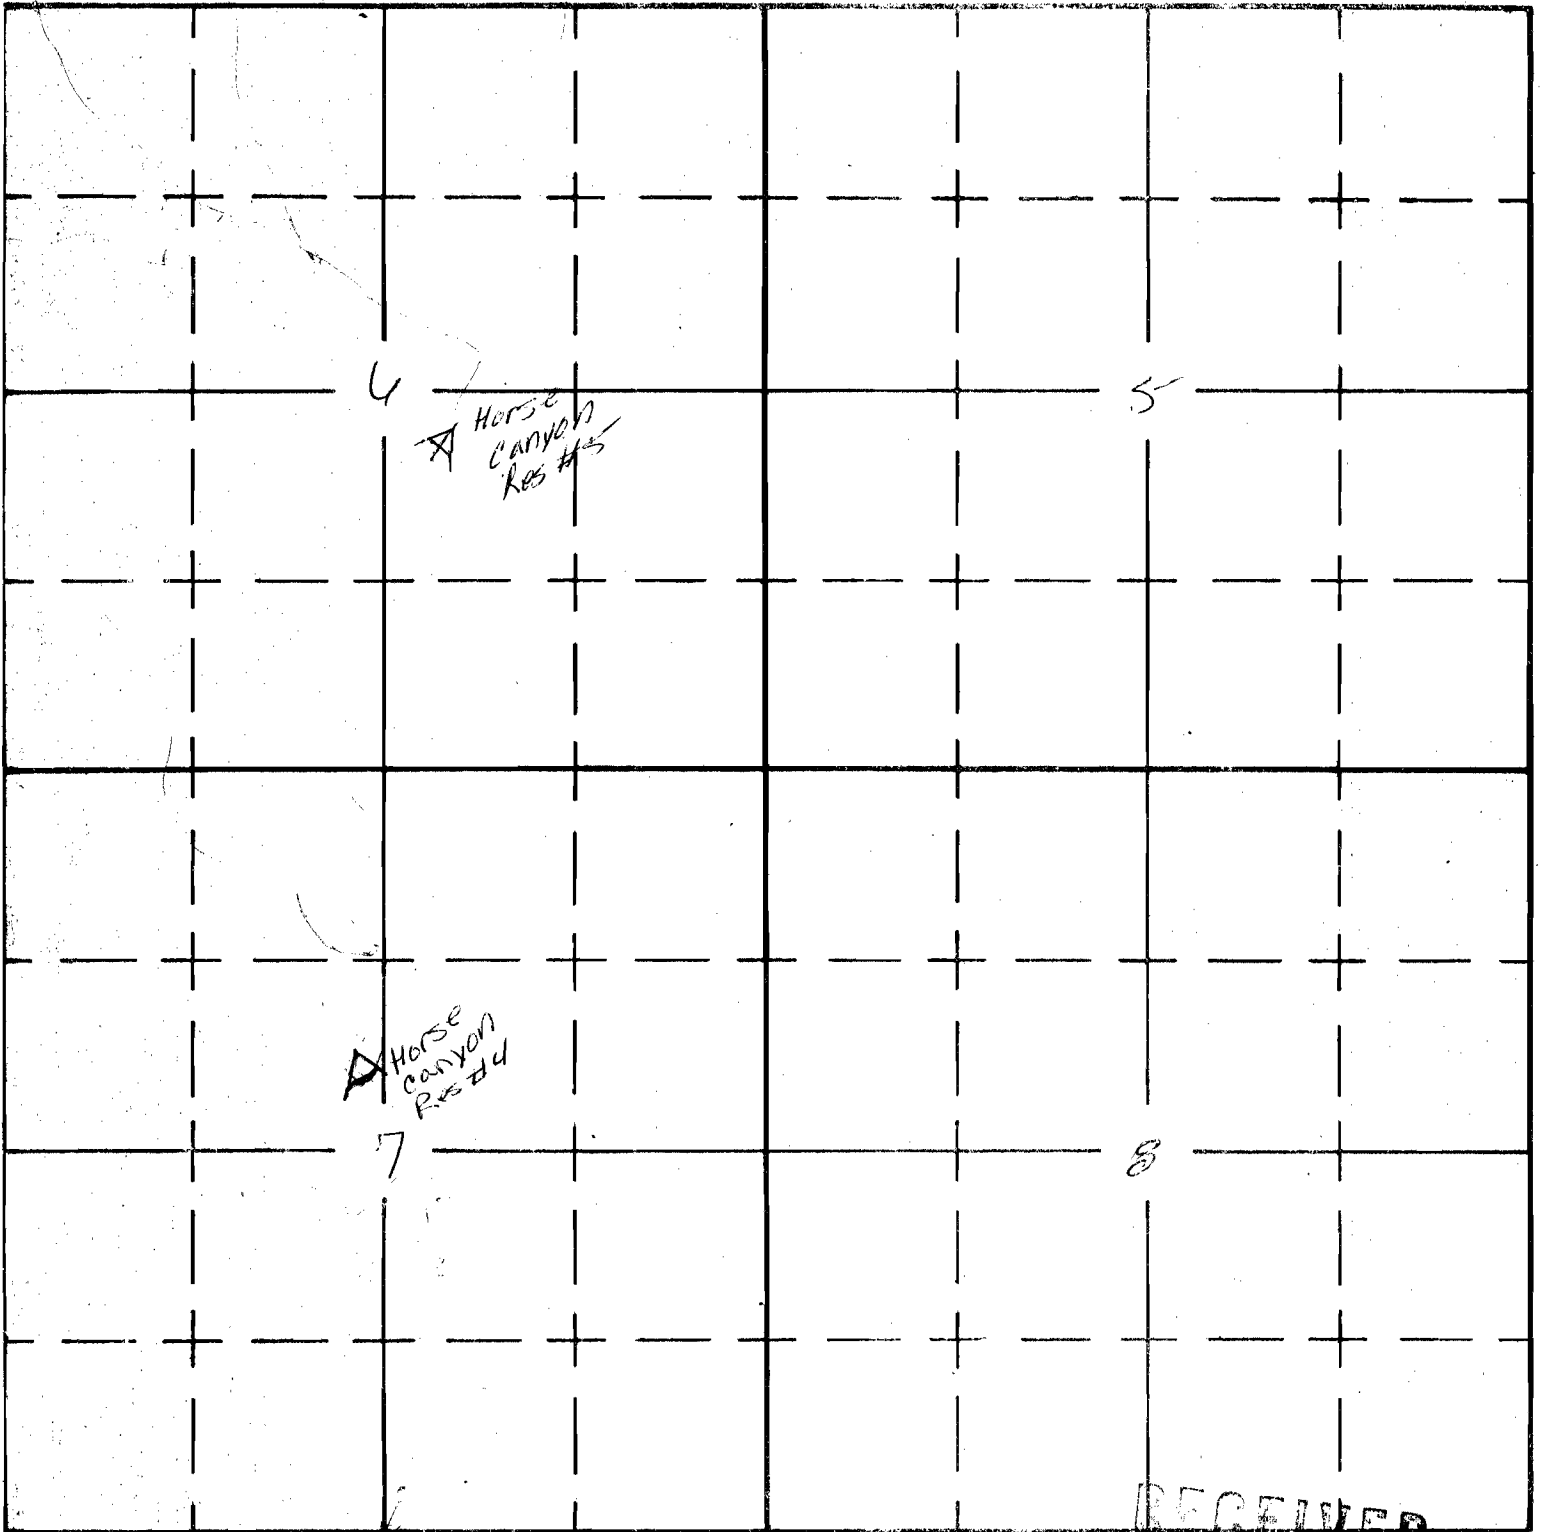

East

South

APPLICATION NO R-68499

PERMIT NQ R-11039

RECEIVED

AUG 9 1985

WATER RESOURCES DEPT
SALEM, OREGON

RECEIVED
MAR 20 1986
WATER RESOURCES DEPT
SALEM, OREGON