

UNITED STATES
DEPARTMENT OF THE INTERIOR
BUREAU OF LAND MANAGEMENT

10-5168 Davis Grassy
Res #5
10-5448 Davis Grassy
Res #6


SECTION

9 SE NW
9 SW SW

Oregon State Water Filings

TOWNSHIP 33S, RANGE 37E, W. M.

North

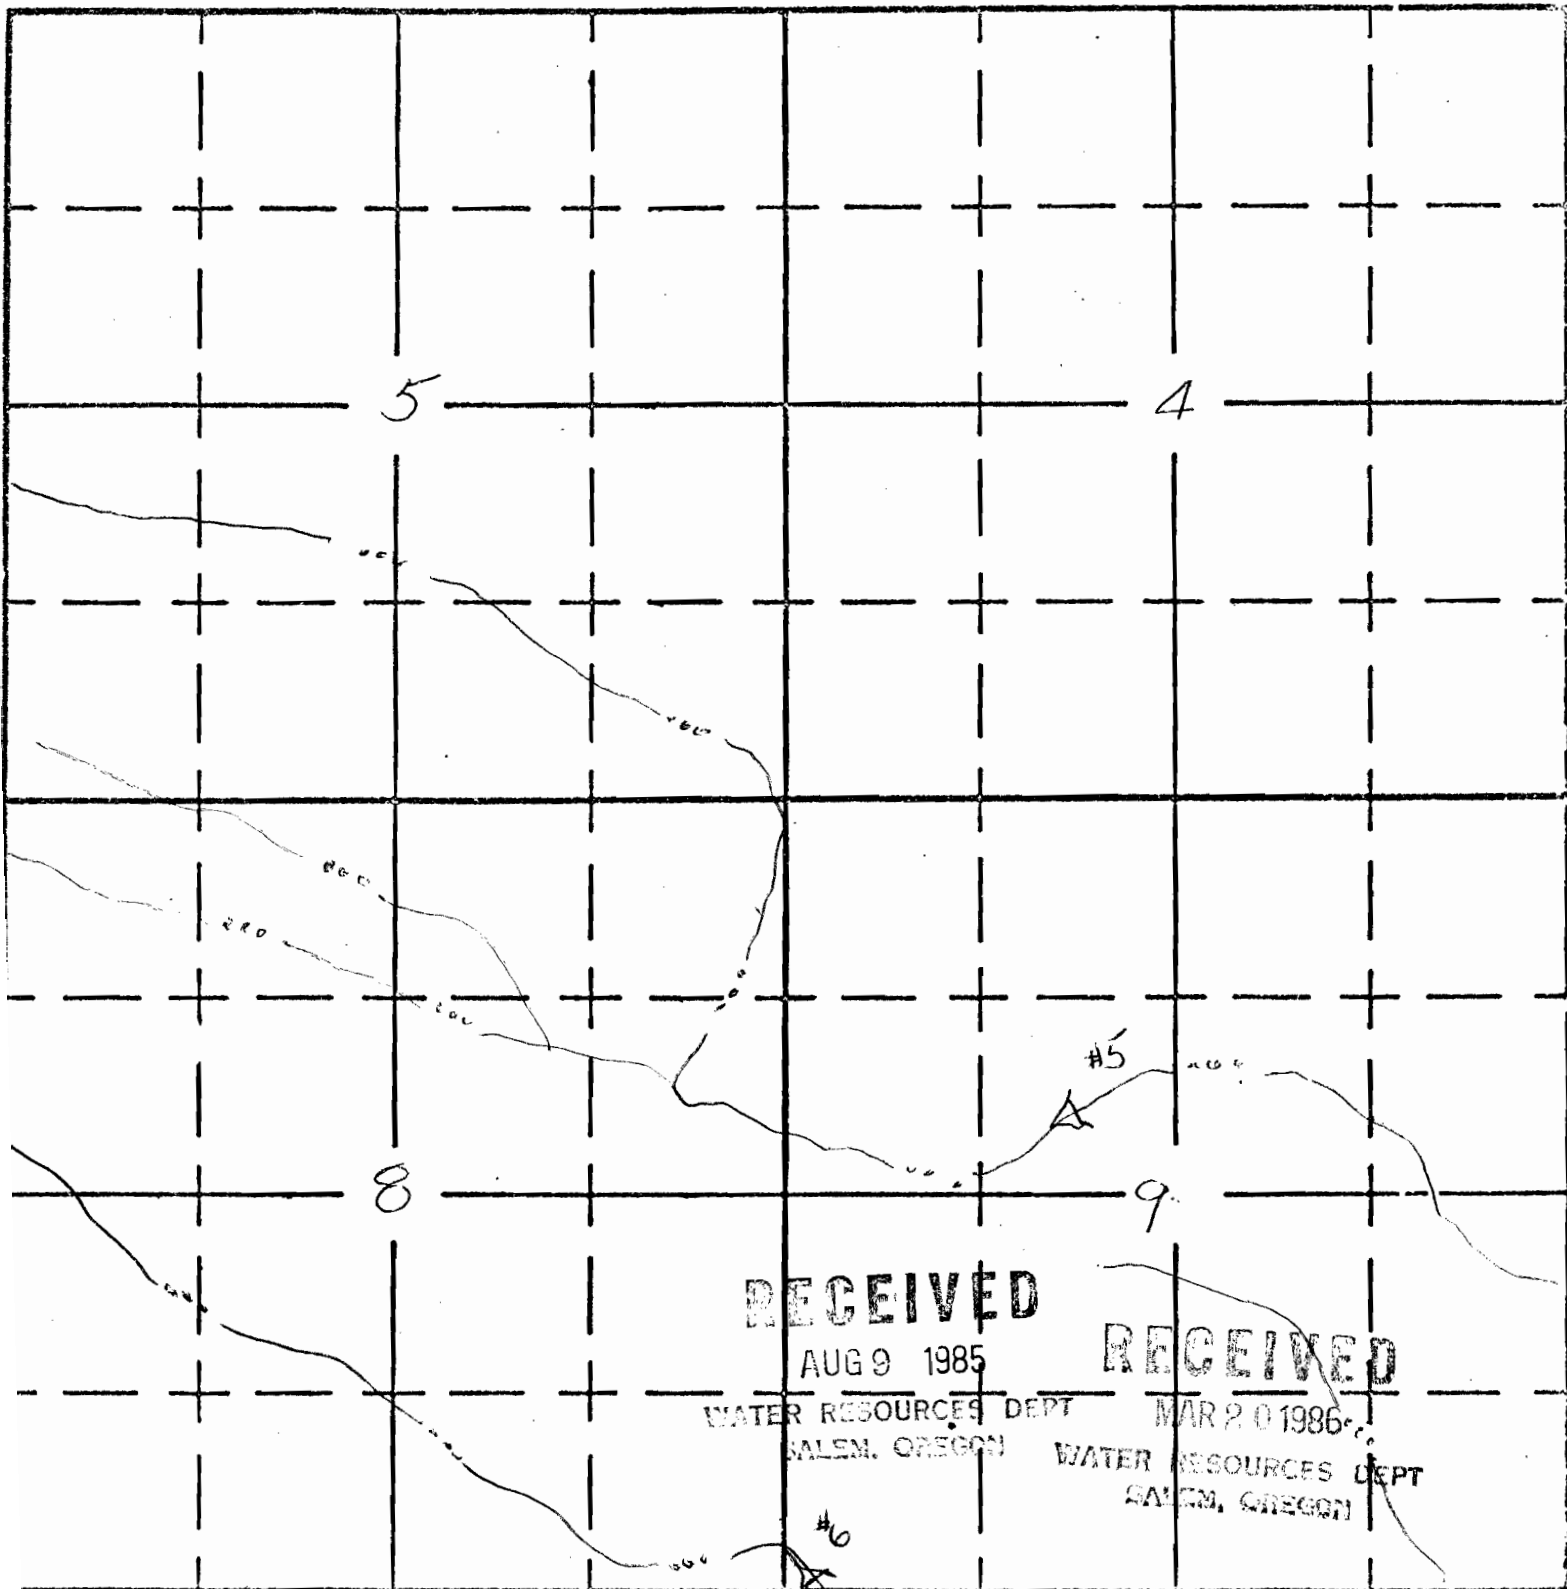

Application No. R-68501
Permit No. R-11040

APPLICATION No.
DEPARTMENT

10-5208
Davis Grassy
Res #7

SECTION

SECTION 16 NW, NW Oregon State Water Filings

TOWNSHIP 37, RANGE 37, W. M.

North

#7

16

RECEIVED

AUG 9 1985

WATER RESOURCES DEPT
SALEM, OREGON


MAR 20 1986

WATER RESOURCES DEPT

Application No. R. 68501

Permit No. R.11040

Souza

APPLICATION No.