


SECTION

23 SE SW
26 SE NW

TOWNSHIP 29 S, RANGE 36 E

10 - #5413
Neals Hill Res.
10 - #5414
Neals sidehill
Spring Res.

North

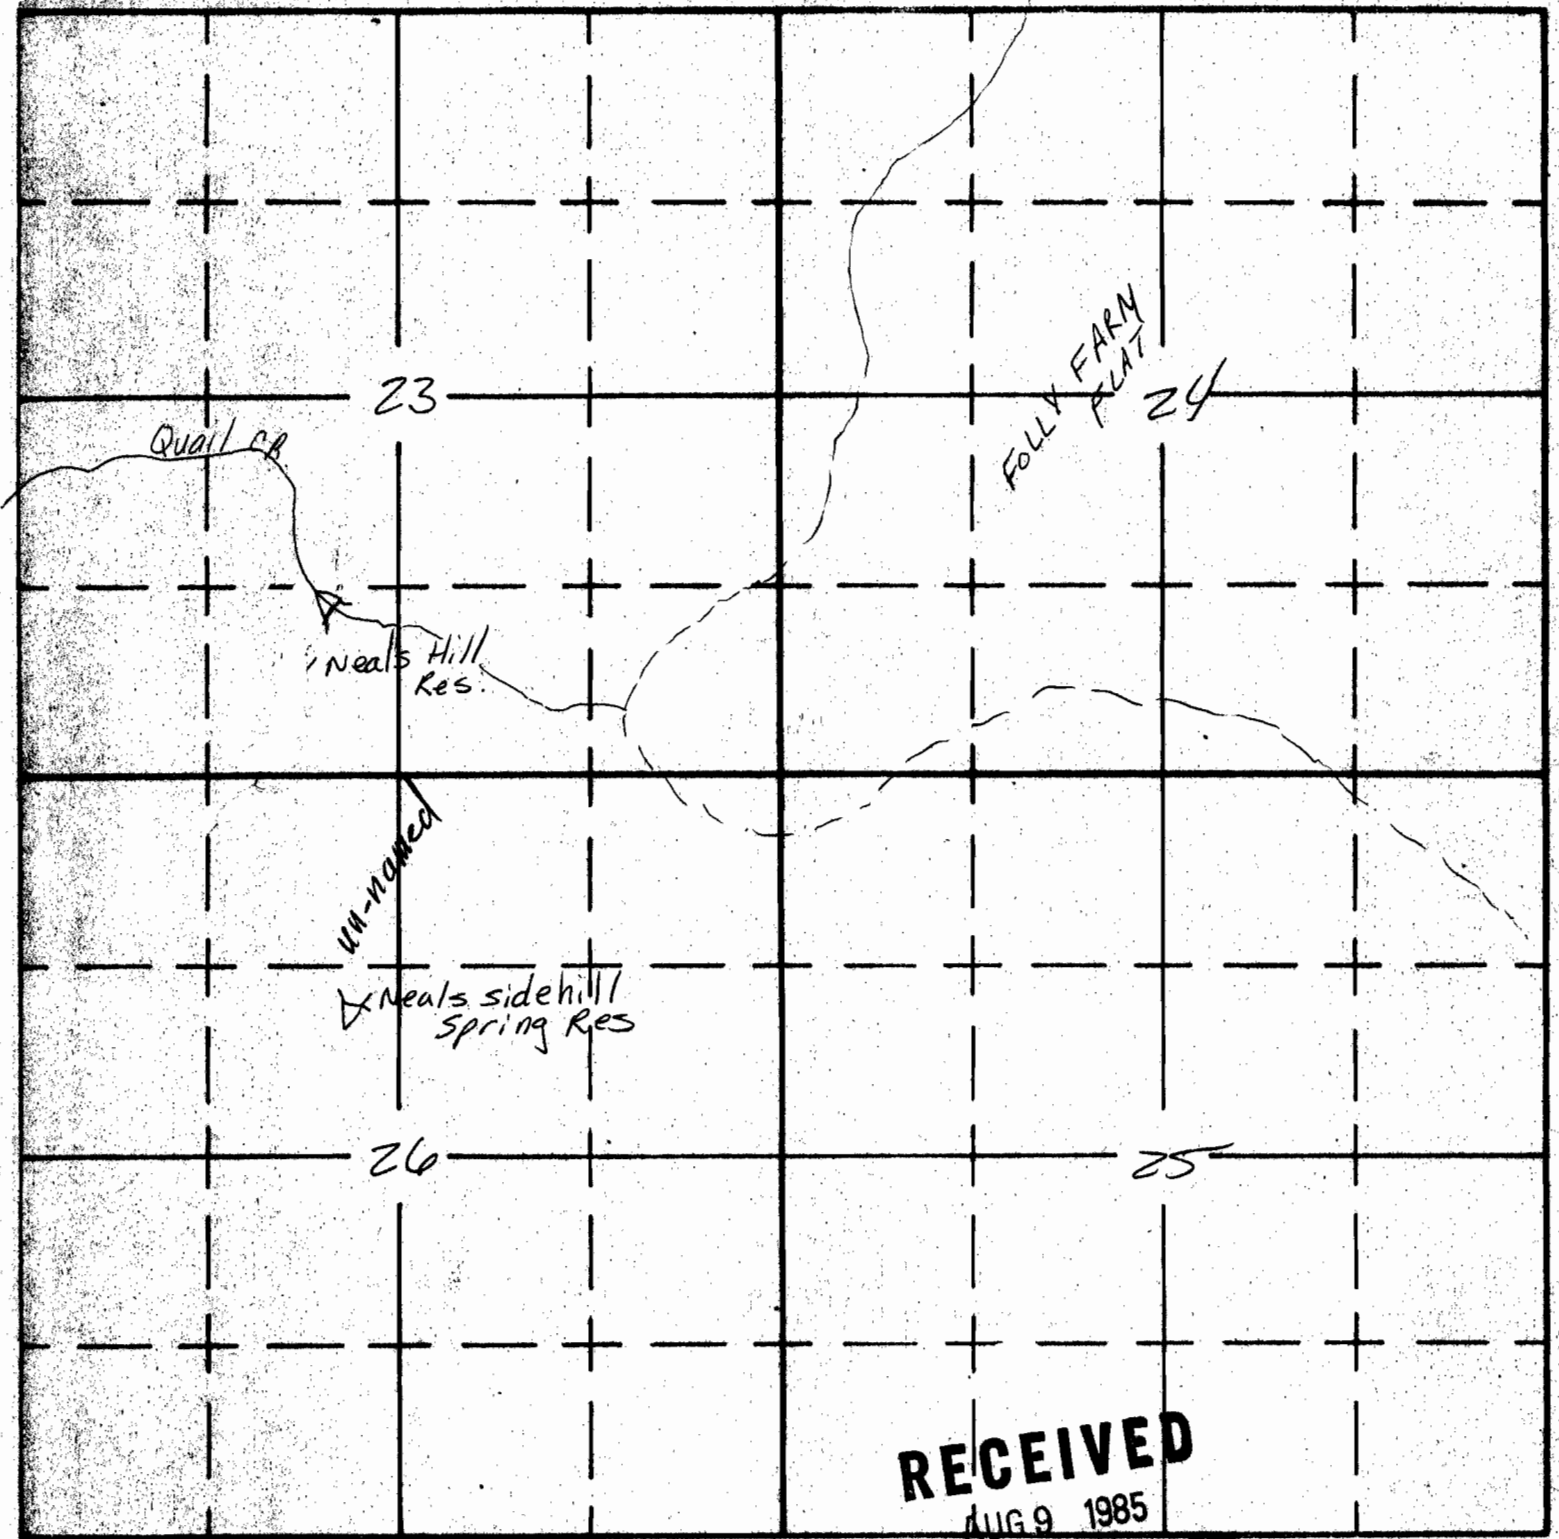

South

RECEIVED

AUG 9 1985

WATER RESOURCES DEPT
SALEM, OREGON

RECEIVED

MAR 20 1986

WATER RESOURCES DEPT
SALEM, OREGON

APPLICATION NO R.68507

PERMIT NQ

R.11041