


36 SE 1/4
36 SW 1/4

TOWNSHIP 34S, RANGE 32E, W. M.

07-45560
Mr Coyote Res
09-#554
Porky Trail Res

North

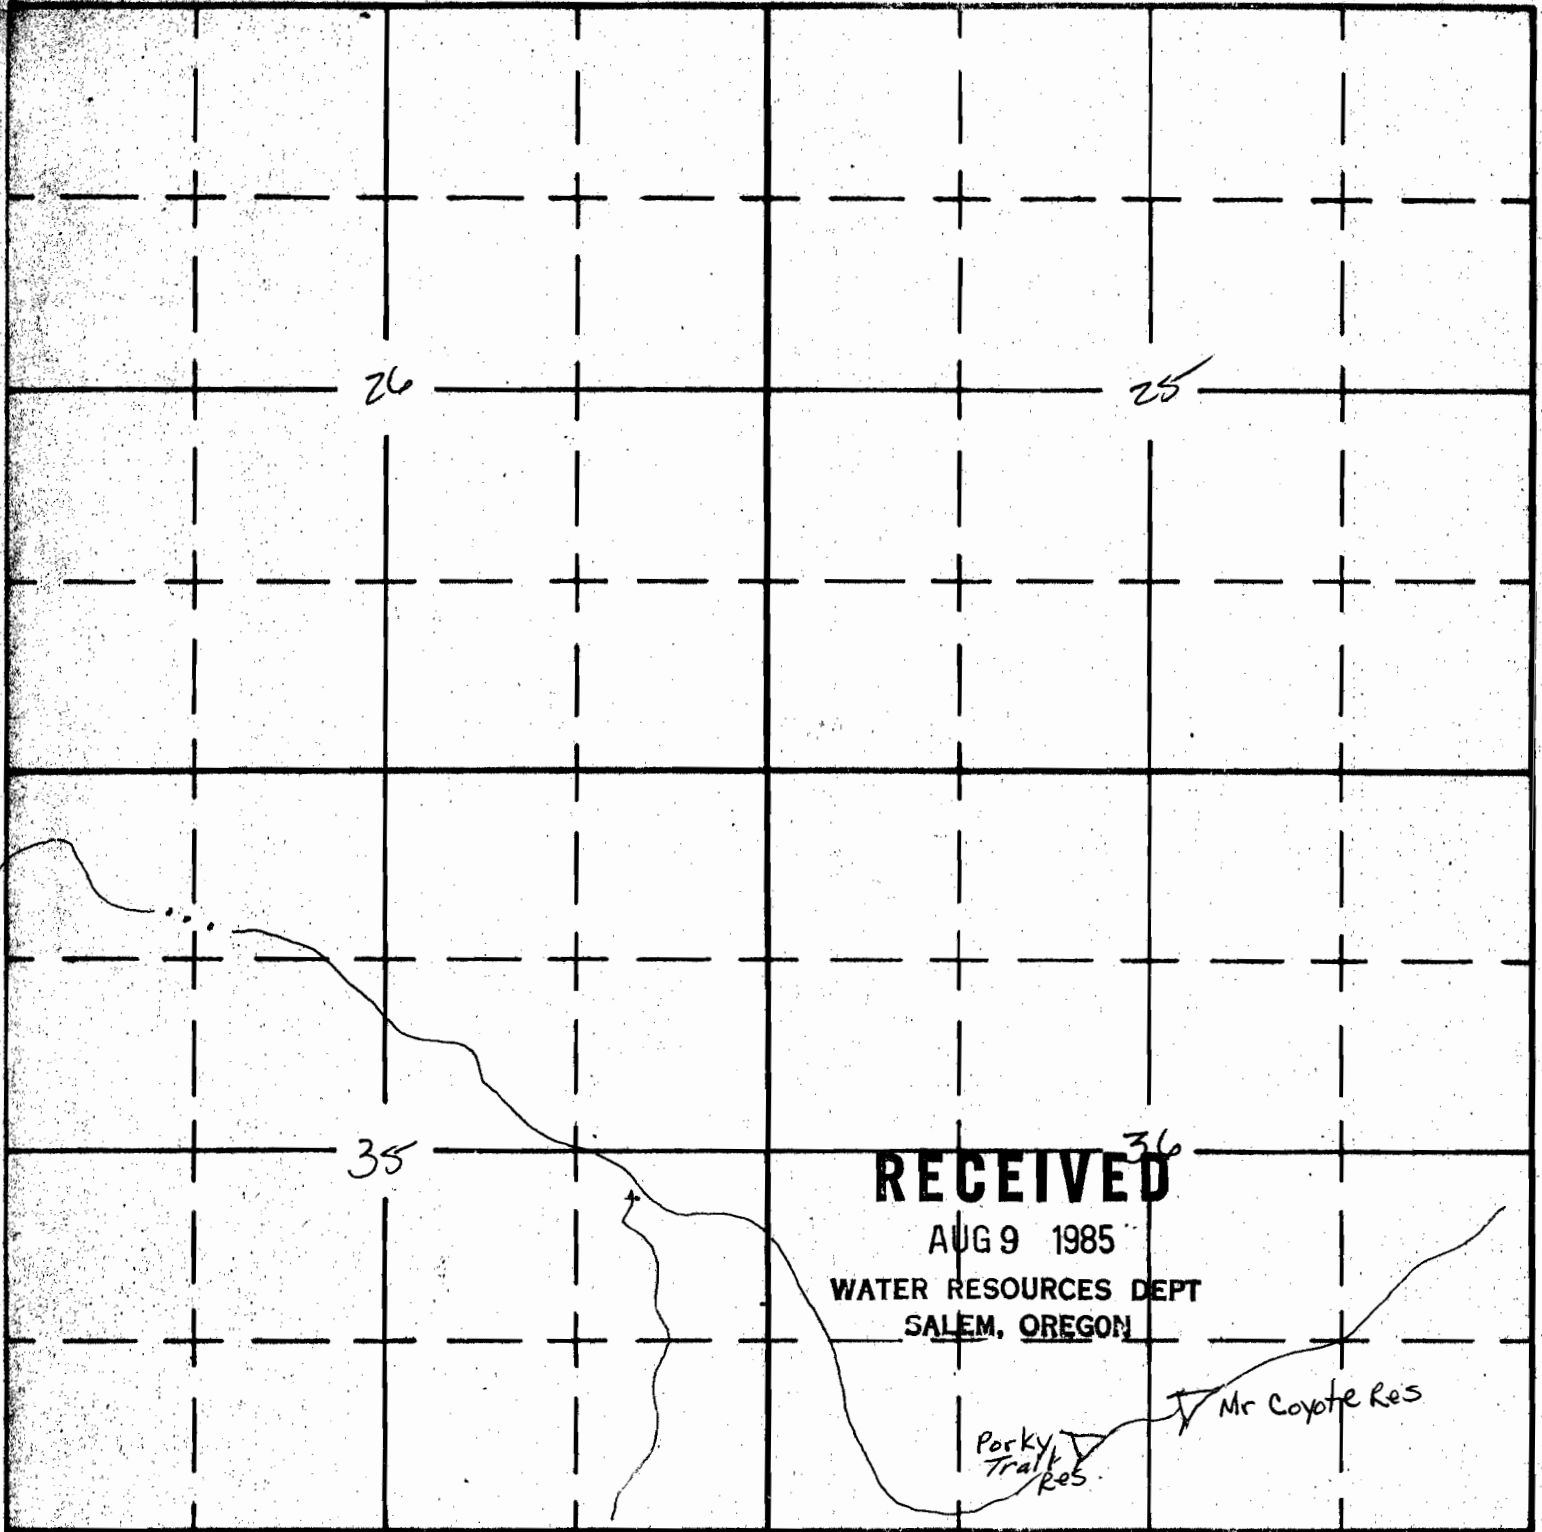

East

South

APPLICATION NO R-68508
PERMIT NQ R-11042

RECEIVED
MAR 20 1986
WATER RESOURCES DEPT
SALEM, OREGON