

SECTION


12 NWSE

11 NENE

TOWNSHIP 35S, RANGE 32 1/2 E, W. M.

09 - #5557
More Horses Res.

09 - 5558
Rabbit brush
Res #1

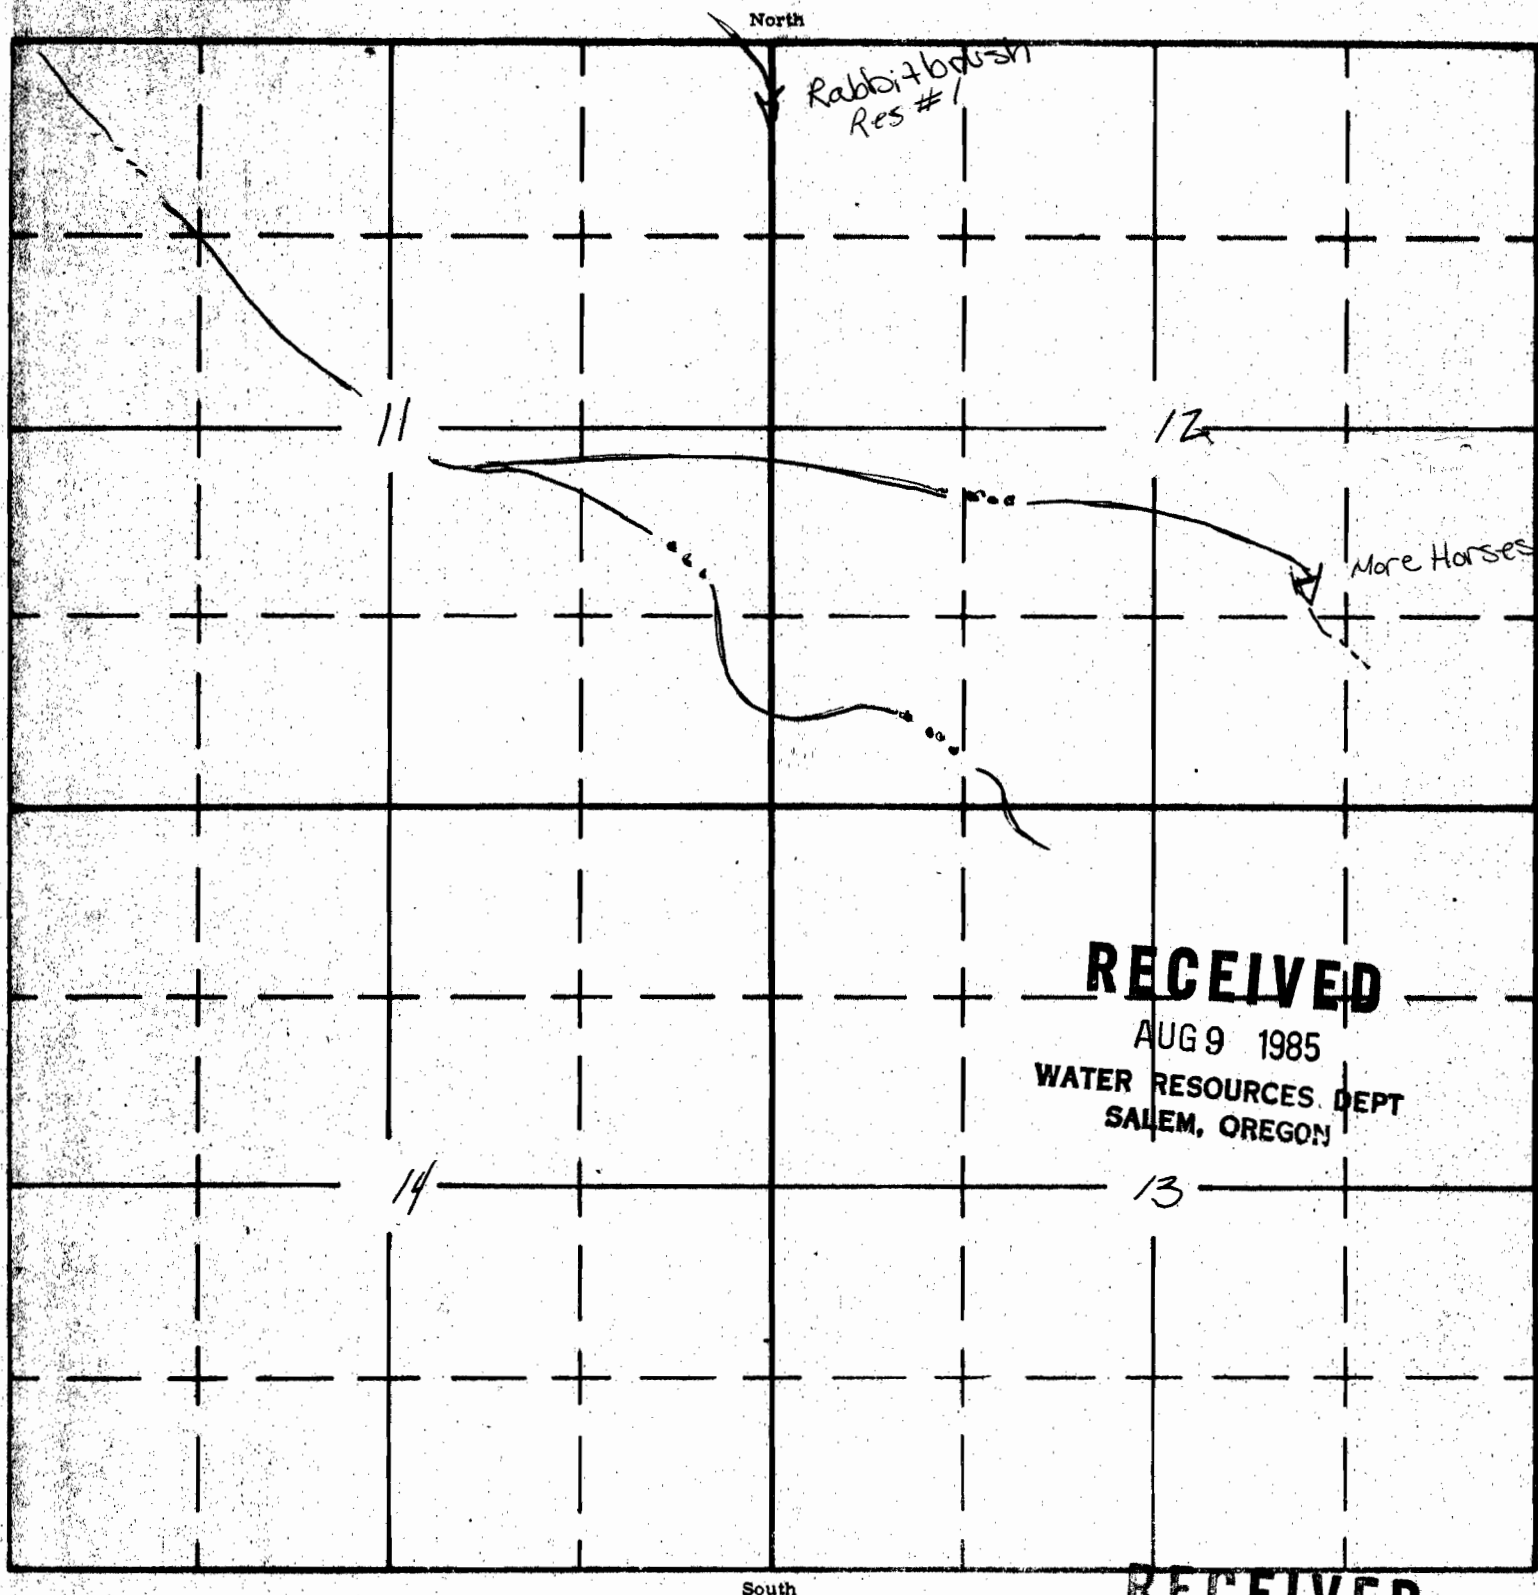

RECEIVED

AUG 9 1985

WATER RESOURCES DEPT
SALEM, OREGON

APPLICATION NO R-68511

PERMIT NO R-11043

RECEIVED

MAR 20 1986

WATER RESOURCES DEPT
SALEM, OREGON