

UNITED STATES
DEPARTMENT OF THE INTERIOR
BUREAU OF LAND MANAGEMENT

10-5224 Frankie's Sand box Res


SECTION

12 NWSW

Oregon State Water Filings

TOWNSHIP 34S, RANGE 36E, W. M.

North

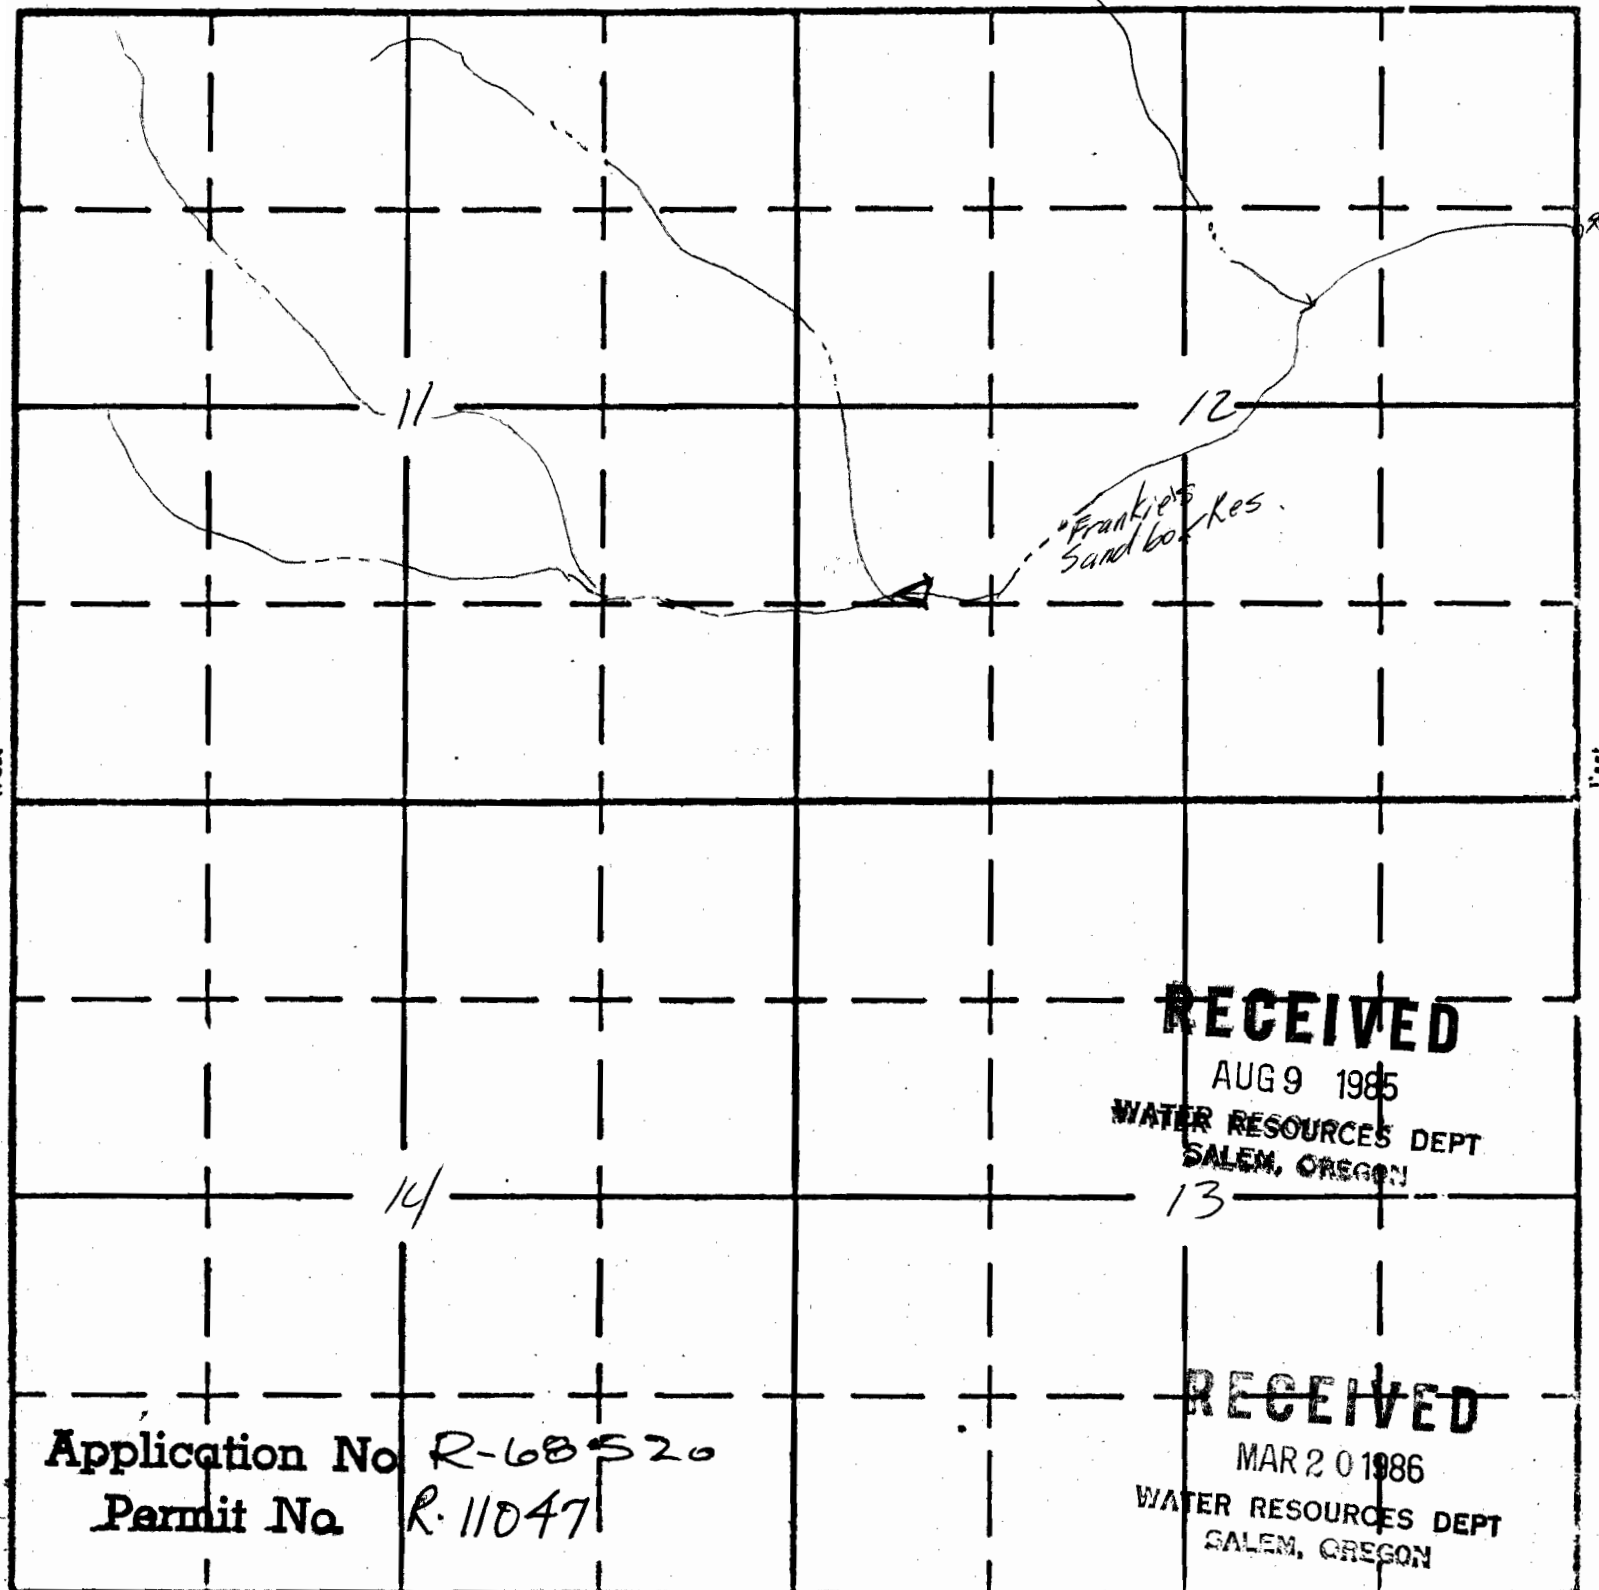

RECEIVED

AUG 9 1985

WATER RESOURCES DEPT
SALEM, OREGON

RECEIVED

MAR 20 1986

WATER RESOURCES DEPT
SALEM, OREGON

Application No R-68520

Permit No R-11047

South

APPLICATION No.

UNITED STATES
DEPARTMENT OF THE INTERIOR
BUREAU OF LAND MANAGEMENT

Desert Gap Res #2
10-5435

Desert Gap Res #1
10-5434

SECTION


30 SWSE

30 SWSE

Oregon State Water Filings

TOWNSHIP 34S, RANGE 36E, W. M.

North

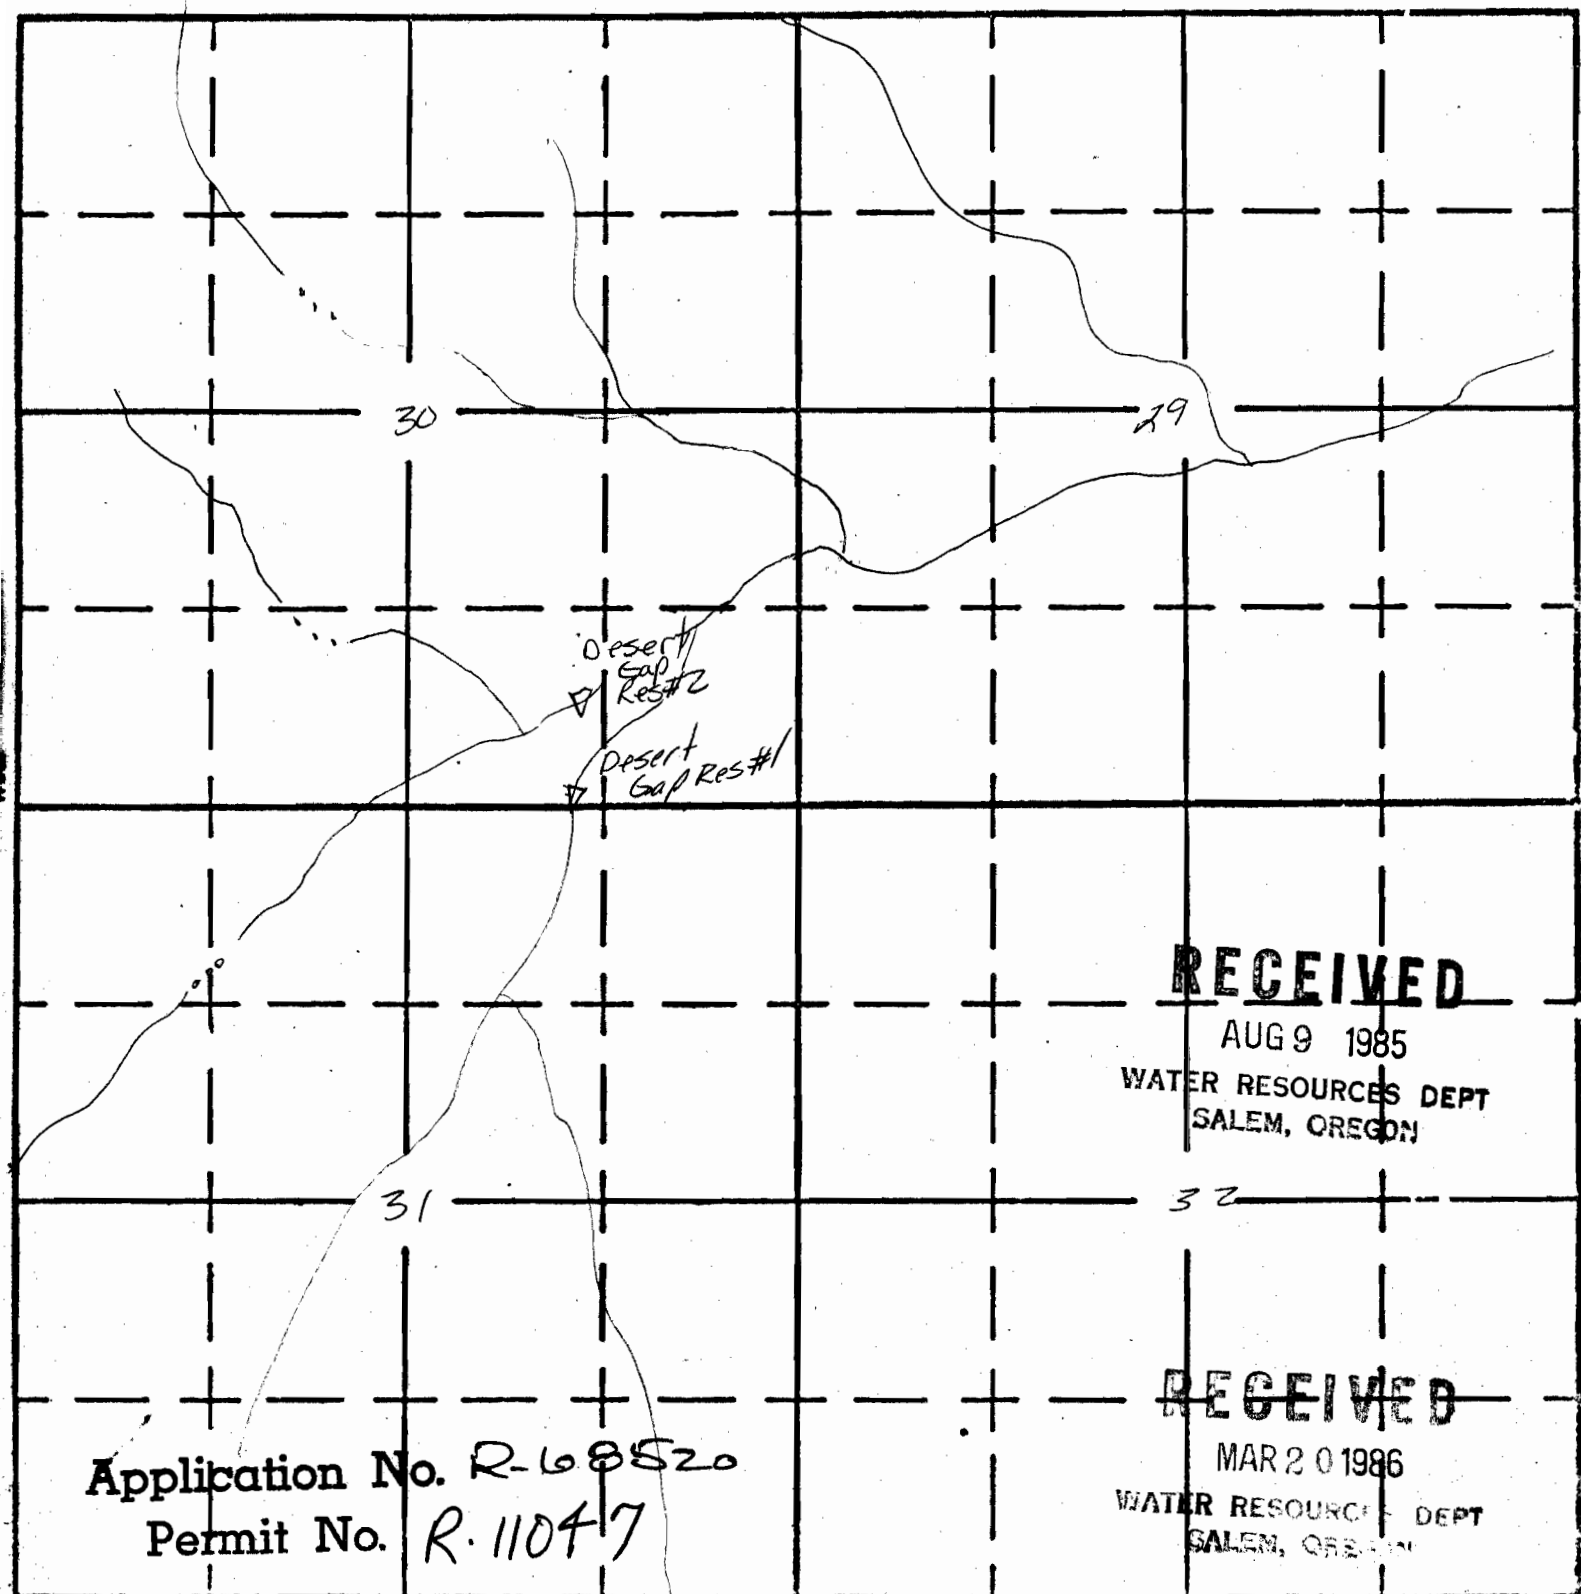

RECEIVED

AUG 9 1985

WATER RESOURCES DEPT
SALEM, OREGON

RECEIVED

MAR 20 1986

WATER RESOURCES DEPT
SALEM, OREGON

Application No. R-68520
Permit No. R-11047

South

APPLICATION NO.