


T. 3N., R. 22E., W.M.

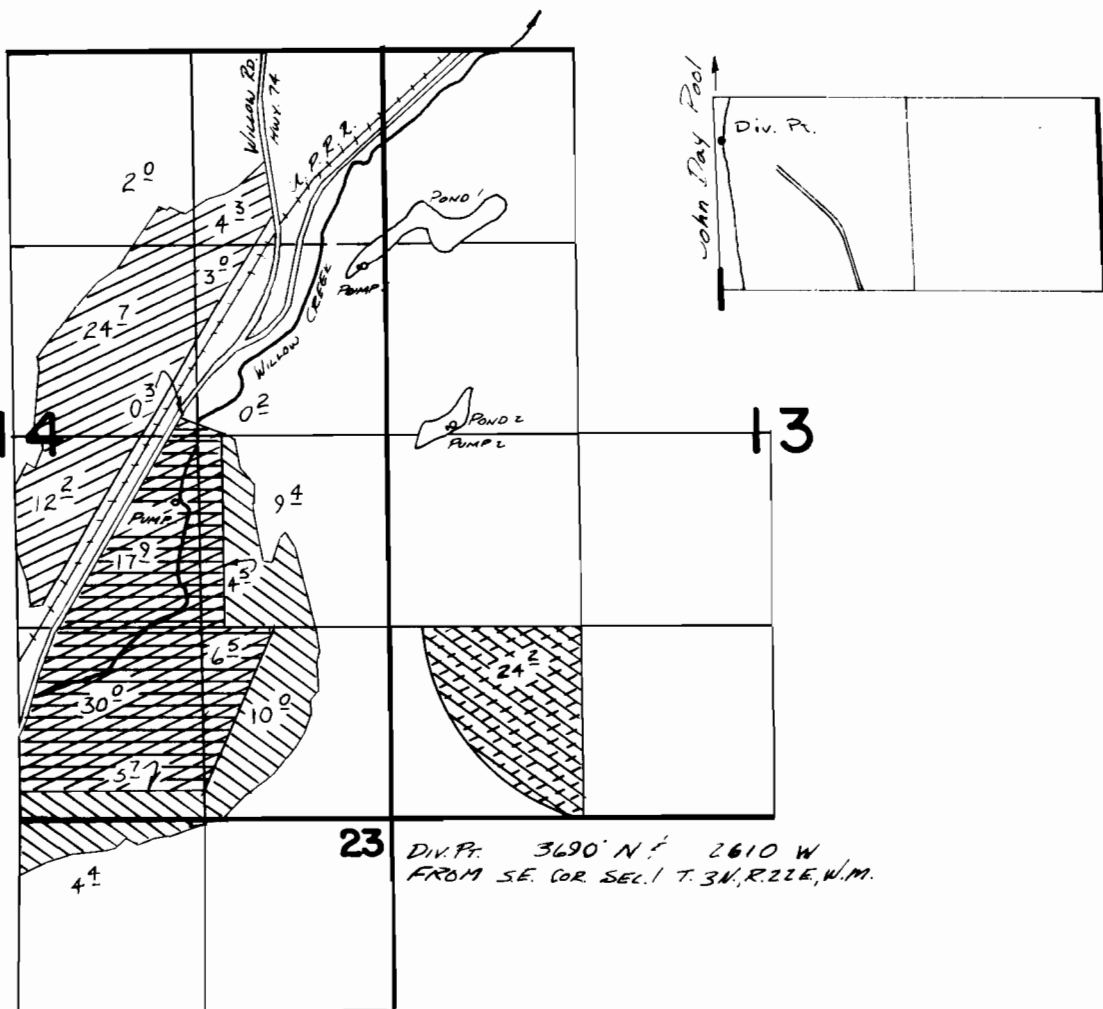

DAVIS  
PRIMARY  
SULLIVAN



DAVIS  
SUPPL.  
SCHIRMISHER

**FINAL PROOF SURVEY**  
UNDER

Application No. **46806** Permit No. **35002**  
IN NAME OF

**LeoAnna A. Schrimsher et al.**

Surveyed **APRIL 11 1974**, by **L. E. GAYLOR**  
**AUG. 25 82** **V. L. CHURCH**