35003

51769

51768
52606

T. 3N., R. 22E., W. M.

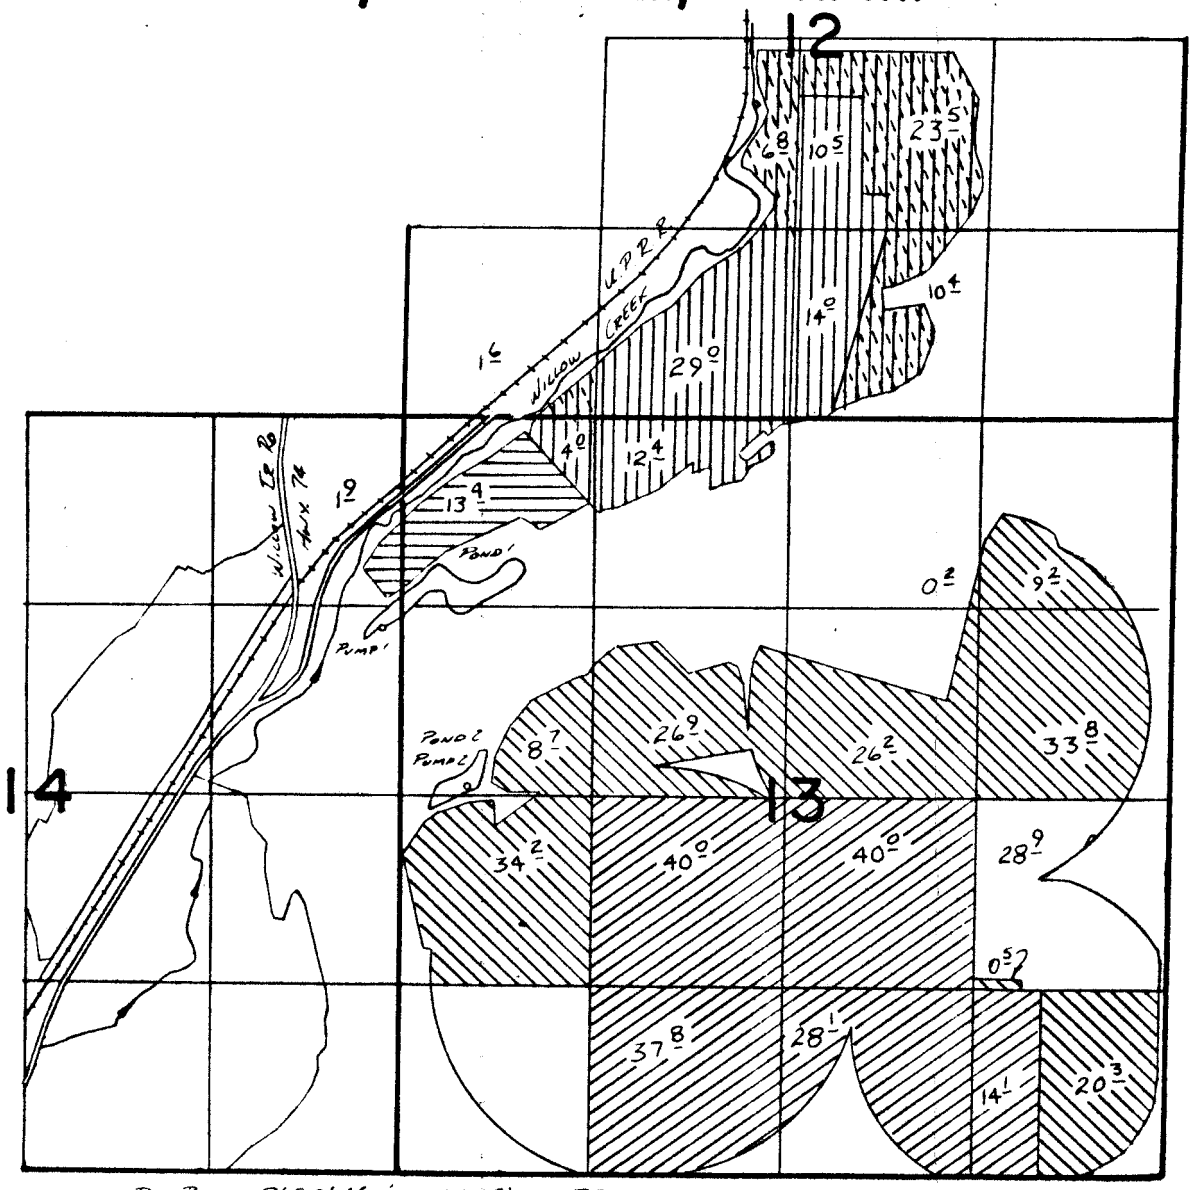

DIV. PT. 3690' N & 2610' W FROM SE COR. SEC. 1 T. 3N, R. 22E, W.M.

SULLIVAN PRIMARY PER. 35003

SULLIVAN SUPPLEMENTAL PER 35005

SULLIVAN PRIMARY PER. 35004

CRISP SUPPLEMENTAL PER. 35005

CRISP PRIMARY PER. 35005

FINAL PROOF SURVEY

UNDER

APPL.	PER.
46807	35003
46808	35004
46809	35005

IN NAME OF

BRIAN SULLIVAN etal

Surveyed April 11 1974, by L.E. Gould
Aug. 5 1982, V. Church

104-L
NSP DIV. PT.