

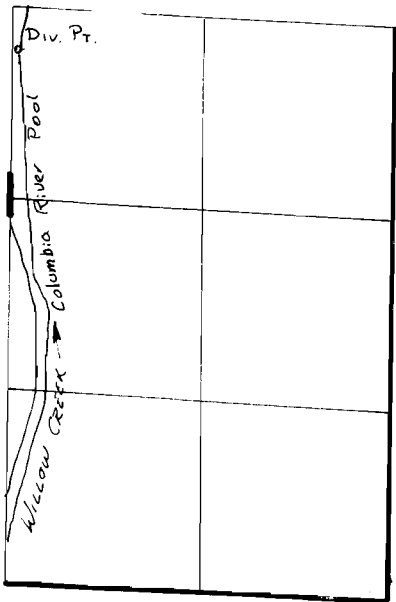


T. 3N., R. 22E., W.M.

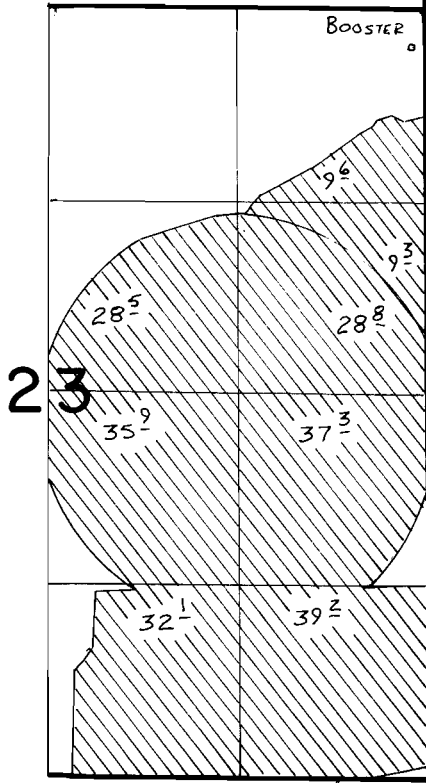

Div. Pt. Loc: 3690' N AND 2610' W
FROM SE COR. SEC. 1

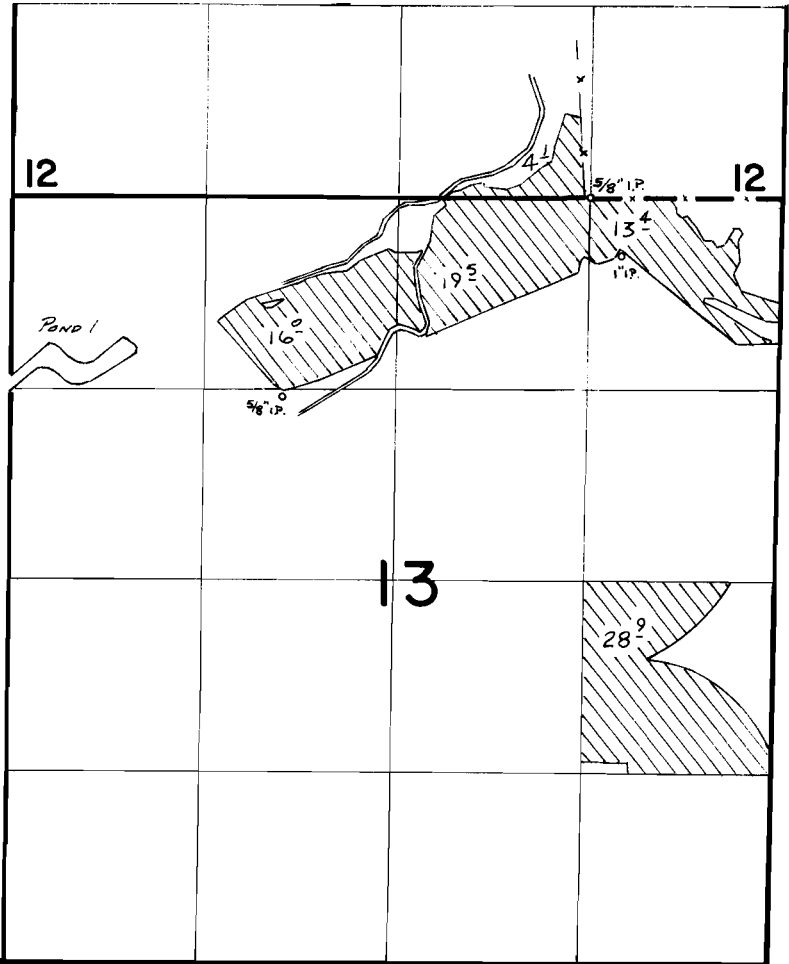

FINAL PROOF SURVEY
UNDER

APPL. 53497 PER. 38225
IN NAME OF

ORIS & DORIS CRISP et al

SURVEYED Oct 13, 1983, by V.L. Church