


T. 27S., R. 15E., W. M.

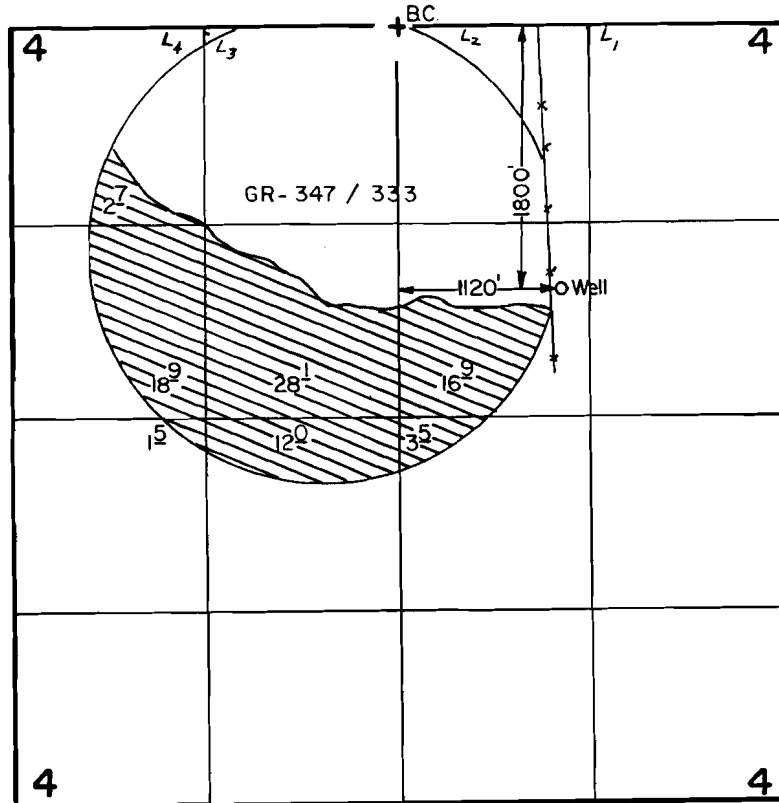

Scale : 1" = 1320'

FINAL PROOF SURVEY UNDER

Application No. G-10917... Permit No. G-10111.....

IN NAME OF

POPLARS RANCH, INC.

Surveyed Sept. 12... 1985., by ..T. Warren.....