


T.2N., R.12E., W.M.

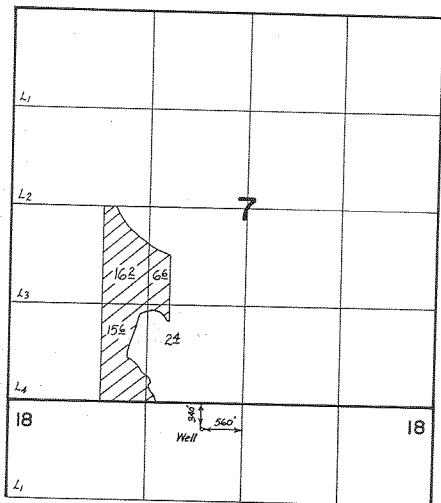


FINAL PROOF SURVEY
UNDER

Application No. G10990 Permit No. G10169
IN NAME OF

BRYCE MOLESWORTH

Surveyed 11-17, 1987, by Vern Church

 

Scale: 1" = 1320'