




# T. 5 S., R. 1 E., W.M.

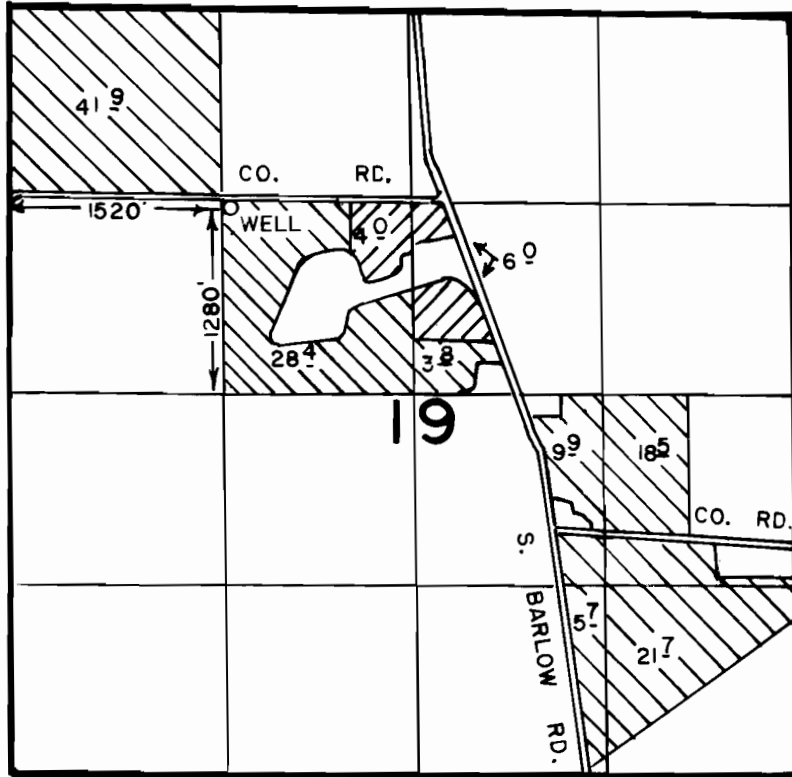

-  SUPPLEMENTAL ACREAGE
-  PRIMARY ACREAGE

## FINAL PROOF SURVEY UNDER

Application No. G-11399 Permit No. G-10575  
IN NAME OF

CARL P. BREMER - DOUGLAS L. & DENNIS K. HOPPER

Surveyed MAY 4 1990, by T.M. WARREN.