


T. 40 S., R. 18 E., W.M.

COPY

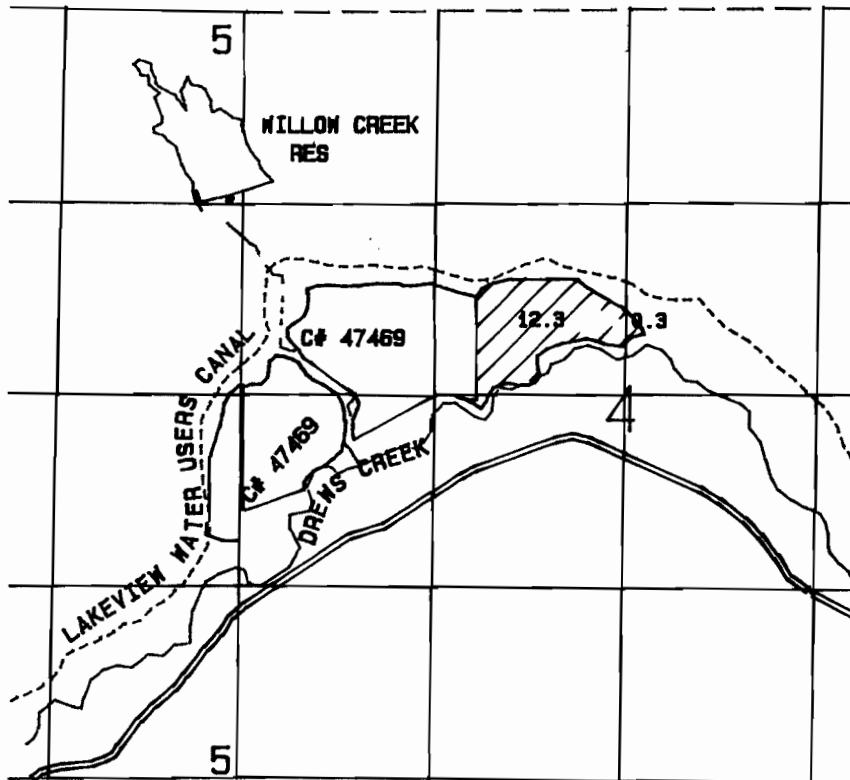

DIV. PT. LOCATED 1280 FT. S. AND 110 FT. W. FROM NE COR. SEC. 5

SCALE: 1 = 1320

FINAL PROOF SURVEY

UNDER

R-54866

R-8508

Application No. 53274 Permit No. 47069

IN NAME OF

JESS ROBERTS

Surveyed Oct. 16, 1987 By B.S. JAMES