


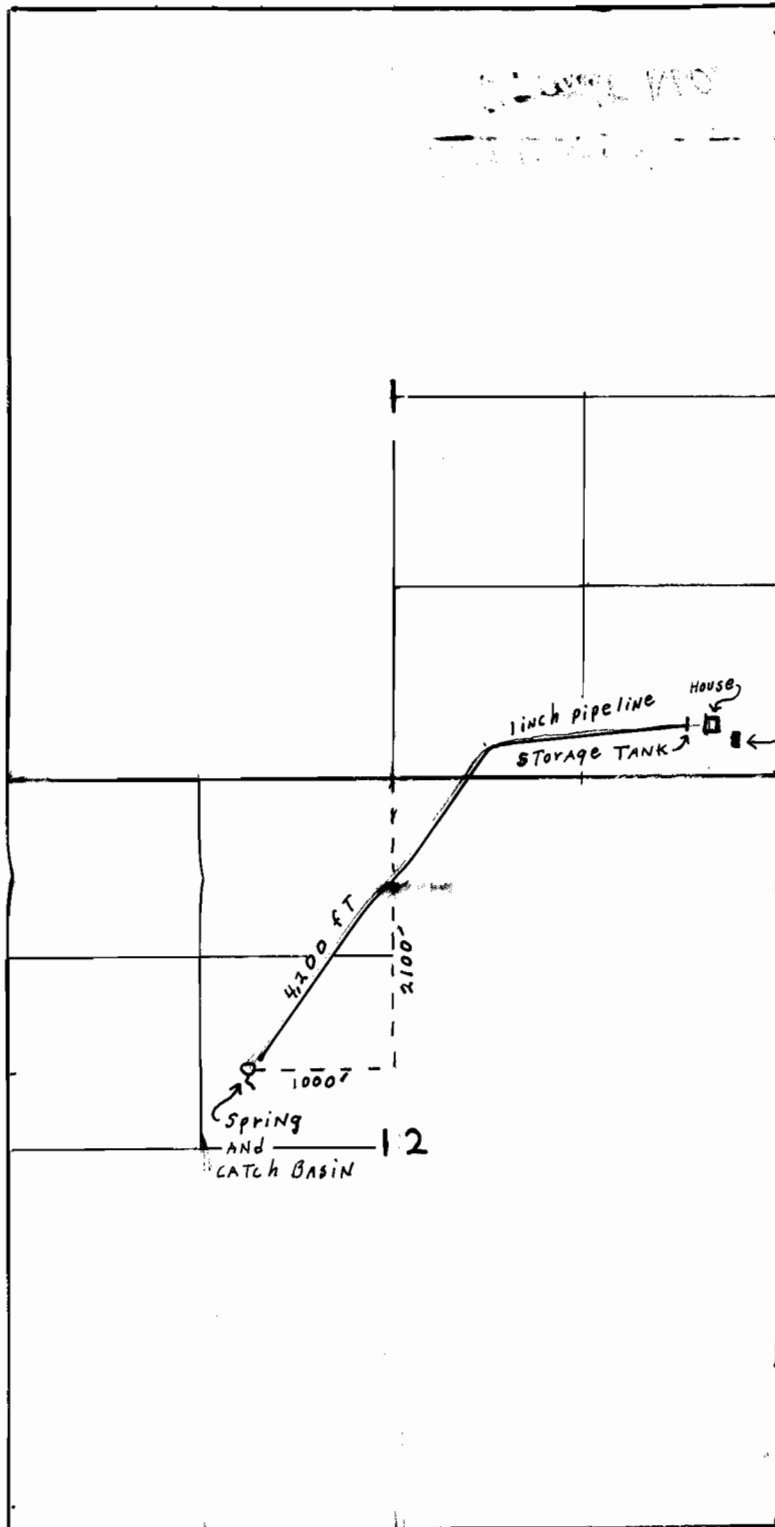

R. 38 E.



T. 9 S.