


T 20S RIW WM

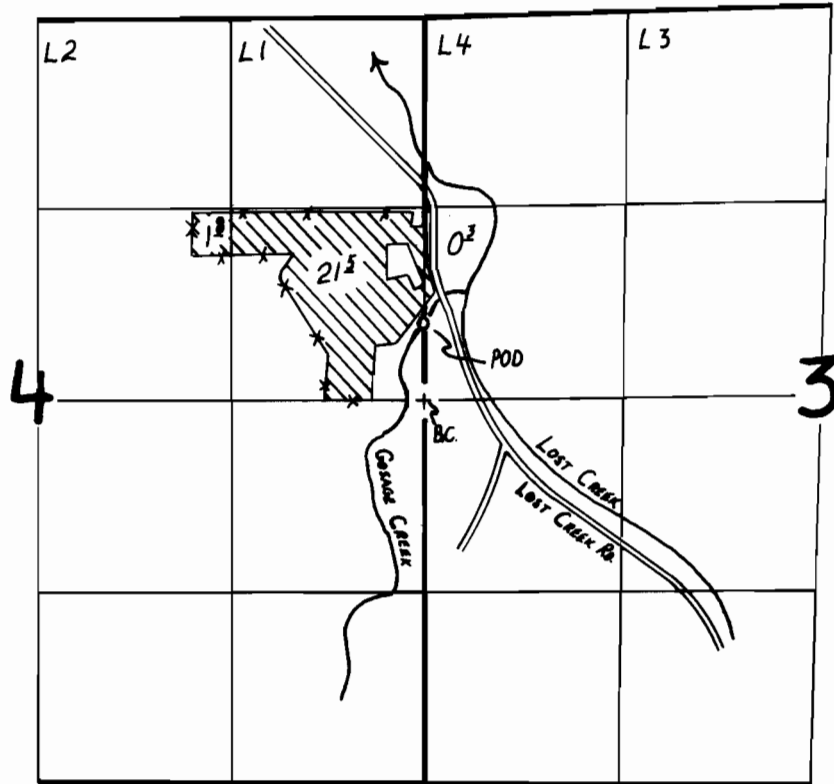

1" = 1320'

FINAL PROOF SURVEY
UNDER

Application No. 56834 Permit No. 42628....
IN NAME OF

.....LEONARD M. & MARY K. SLUSHER.....

Surveyed Aug. 2.... 1990., by T. M. WARREN.....