


T. 35 S., R. 4 W., W. M.

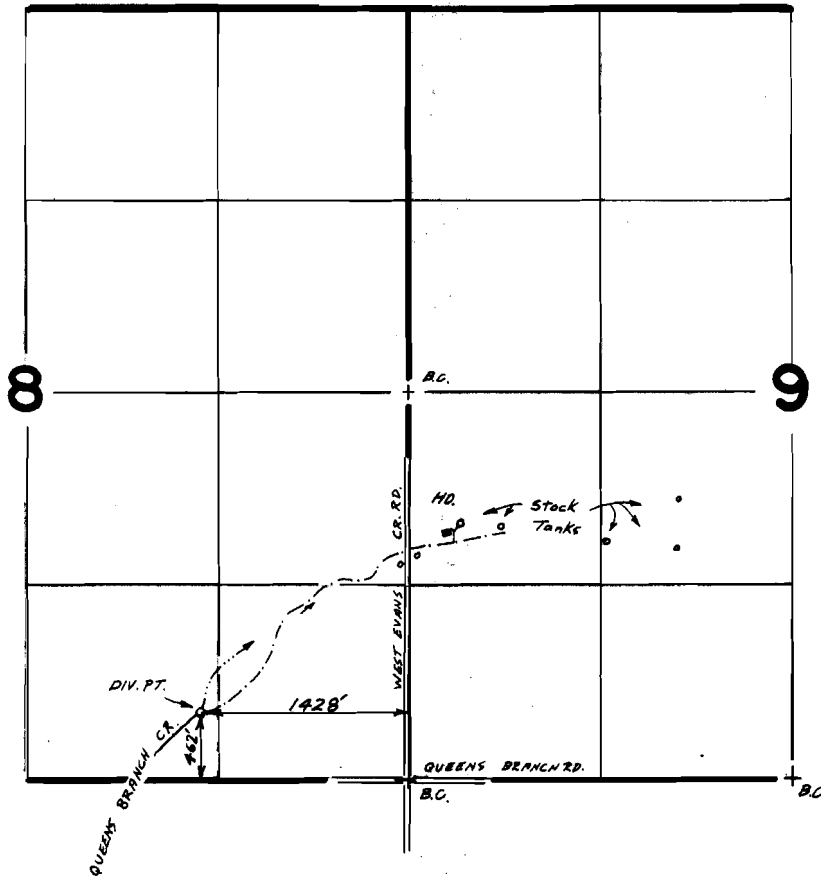

Scale 1" = 1320'

FINAL PROOF SURVEY
UNDER

Application No. 56945 Permit No. 42808

IN NAME OF

CON. F. HOFF

Surveyed Aug. 13, 1985, by B. S. JAMES