


T 22S R 3W WM

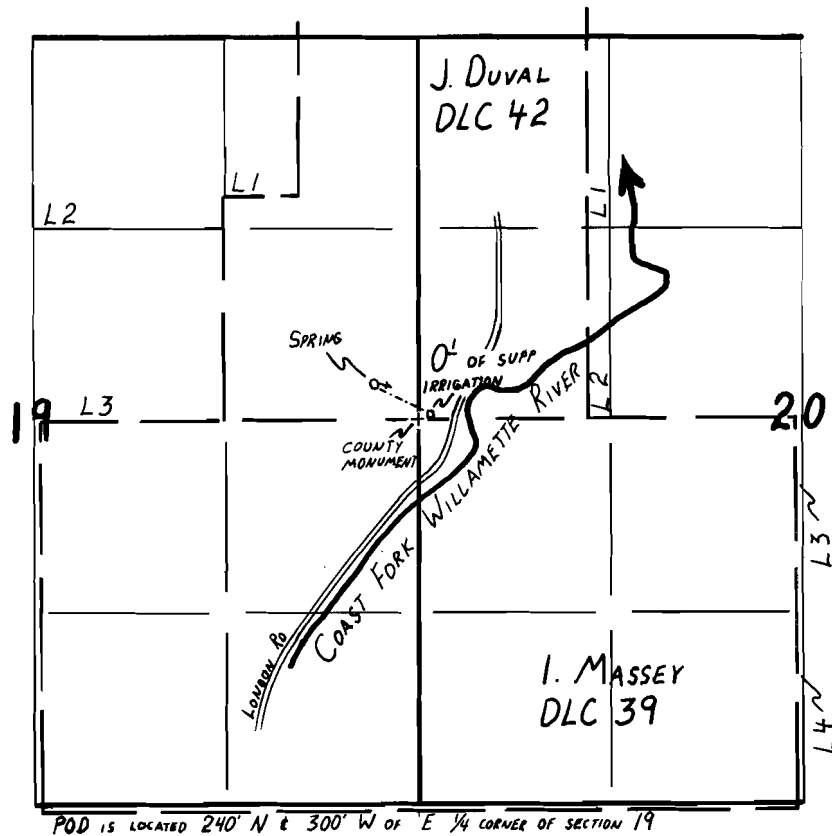

FINAL PROOF SURVEY
UNDER

Application No. 56949. Permit No. 42772...
IN NAME OF

WILLIAM T. & VIOLET M. BOLIN

Surveyed JUNE 12, 1990, by T. M. WARREN