


T.25S., R.5W., W.M.

SECTION 30

JOSEPH HOLMAN

DLC 37

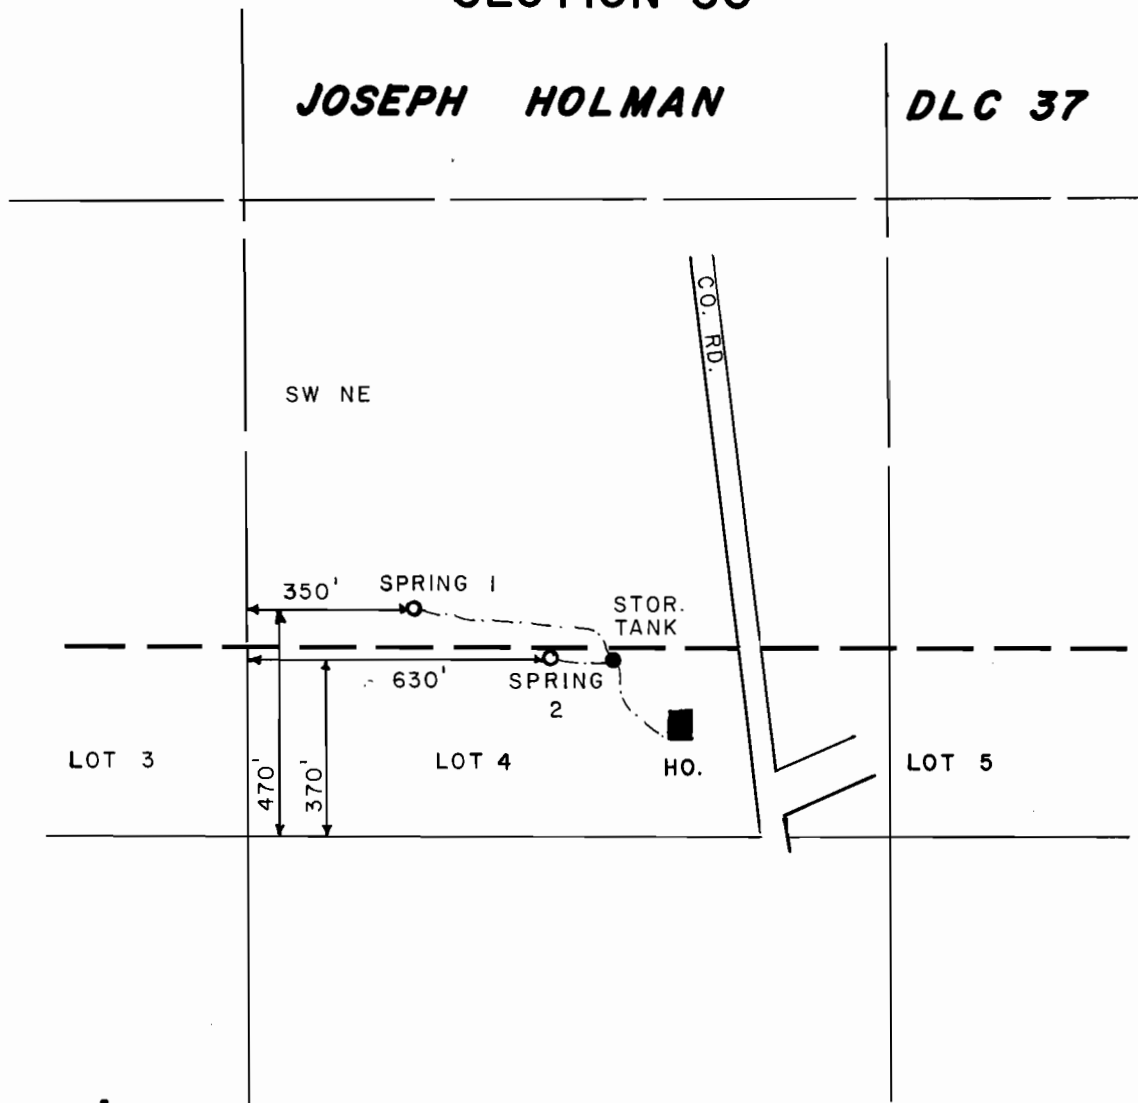

SCALE: 1" = 400'

FINAL PROOF SURVEY

UNDER

Application No. 57938 Permit No. 43689

IN NAME OF

BESSIE RATHBUN

Surveyed JULY 8 1986, by J.M. SCHMORDE

REVISED 10/20/88 jk

PHOTO: SEC. 30, T.25S., R.5W. 1982-83/ZOOM JK