


T. 21 & 22 S., R. 5 W., W.M.

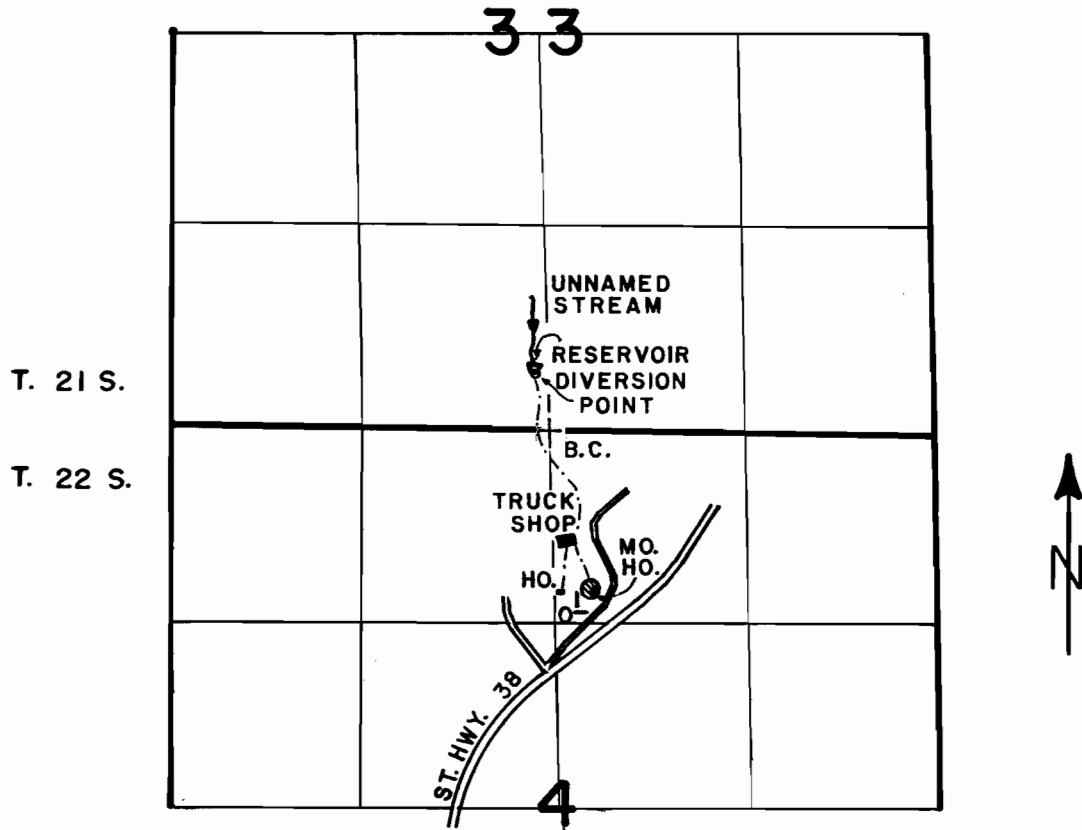

DIVERSION POINT IS LOCATED 370' N. & 70' W. FROM N. 1/4 CORNER SECTION 4.

SCALE: 4" = 1 MILE

FINAL PROOF SURVEY UNDER

R-58049 R-7786
Application No. 58050... Permit No. 43843.....
IN NAME OF

MANLEY WATSON

Surveyed OCT. 15, 1987, by J. M. SCHMORDE