


T.3S.R.10W.W.M.

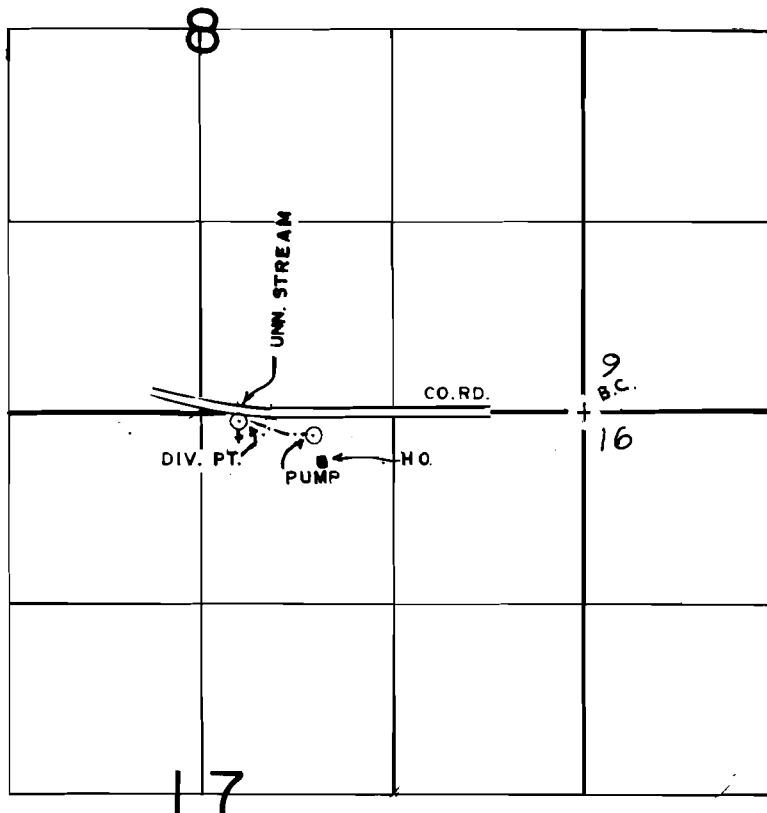

DIV. PT. LOC. 80' S. & 2380' W. OF NE. COR. SEC. 17

FINAL PROOF SURVEY
UNDER

Application No. 5.89.09 Permit No. 44790
IN NAME OF

DAVID M. LOWDELL

Surveyed JAN 24, 1980, by R.G. MUCKEN
OCT 26, 1983 P. PAGTER