


T. 36 S., R. 3 W., W.M.

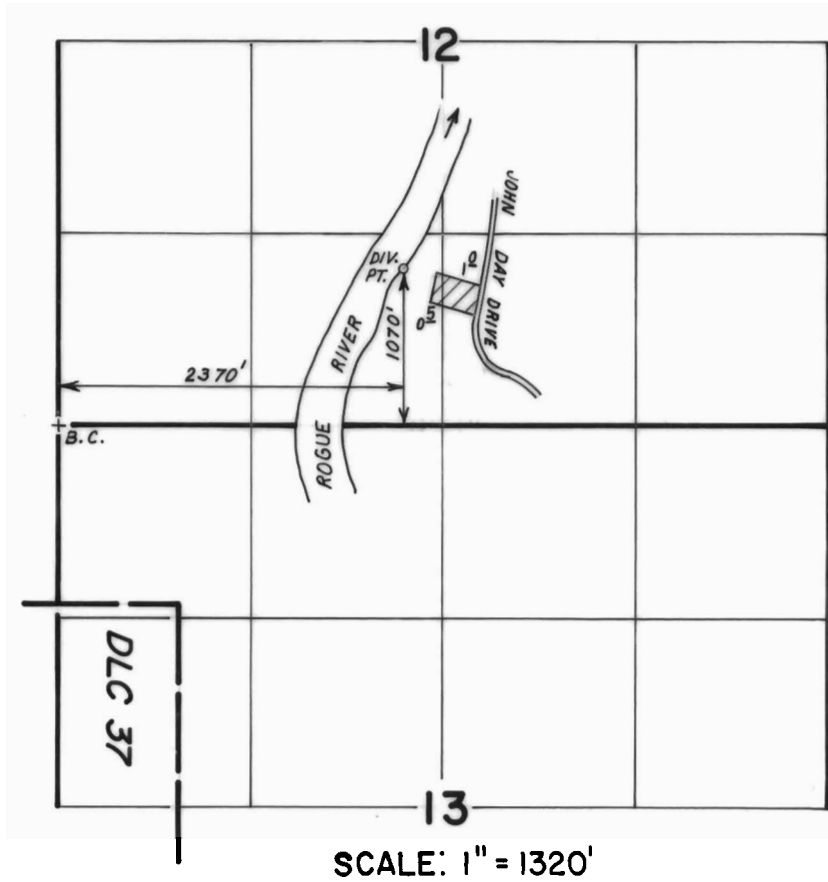

**FINAL PROOF SURVEY**  
UNDER

Application No. **59440** Permit No. **44690**.....  
IN NAME OF

.....**DOREY**.....

Surveyed **FEB. 4** 19**83**, by **B.S. JAMES**.....