


T. 16 S., R. 2 W., W.M.

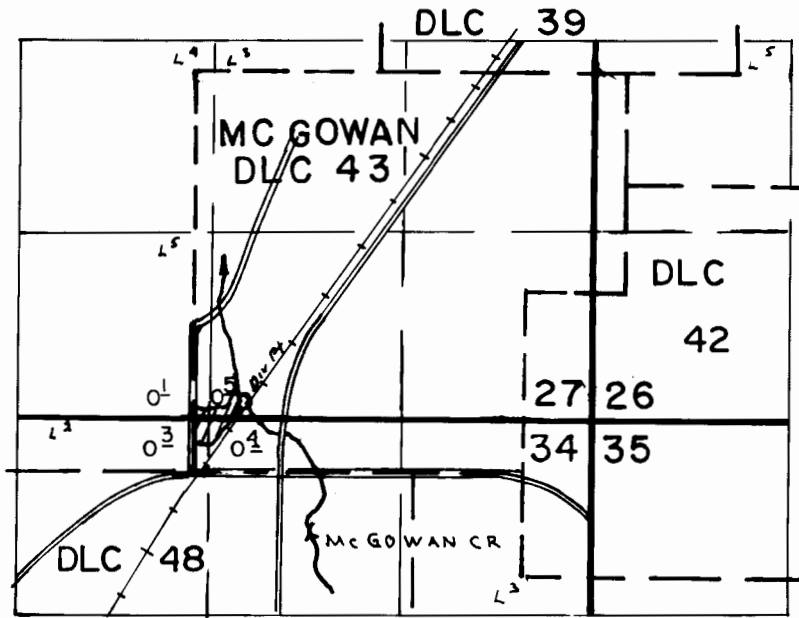

DIV. PT. LOC. 500' N. & 300' E. OF SW. COR. DLC 43

FINAL PROOF SURVEY UNDER

Application No. 59461 Permit No. 44672
IN NAME OF

THOMAS P. JACKSON

Surveyed NOV. 14, 1983, by PAGTER, P.