



T.IS., R.40E., W.M.

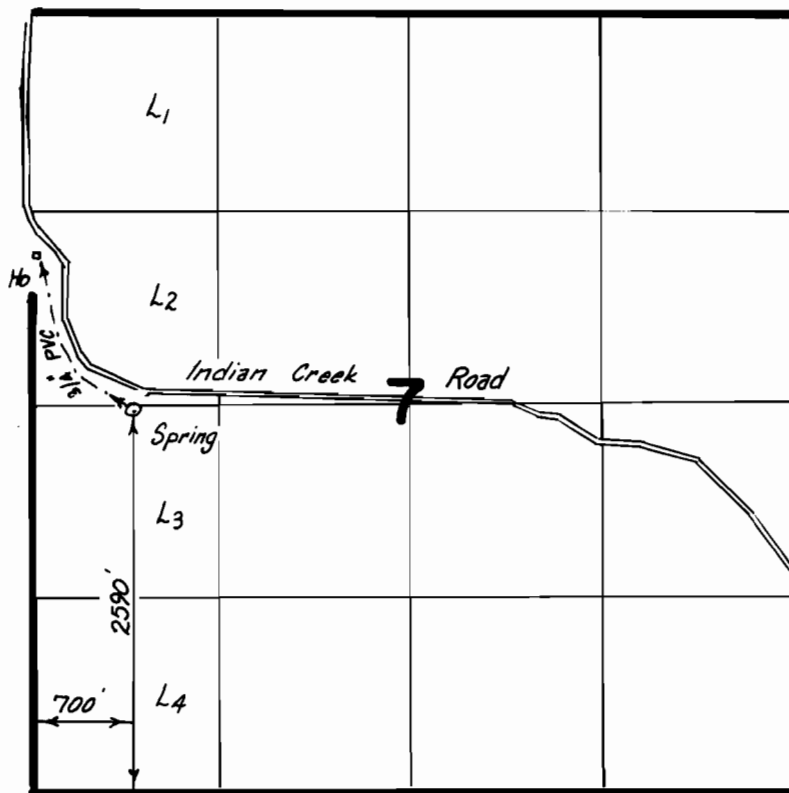

FINAL PROOF SURVEY
UNDER

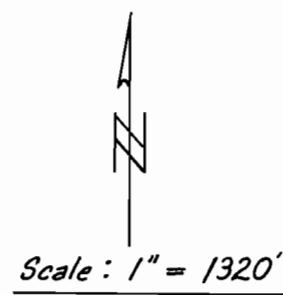

Application No. **60289** Permit No. **44972**
IN NAME OF
DEPARTMENT OF VETERAN'S AFFAIRS

Surveyed 11-9 1987, by Vern Church