


T. 40 S., R. 14 W., W.M.

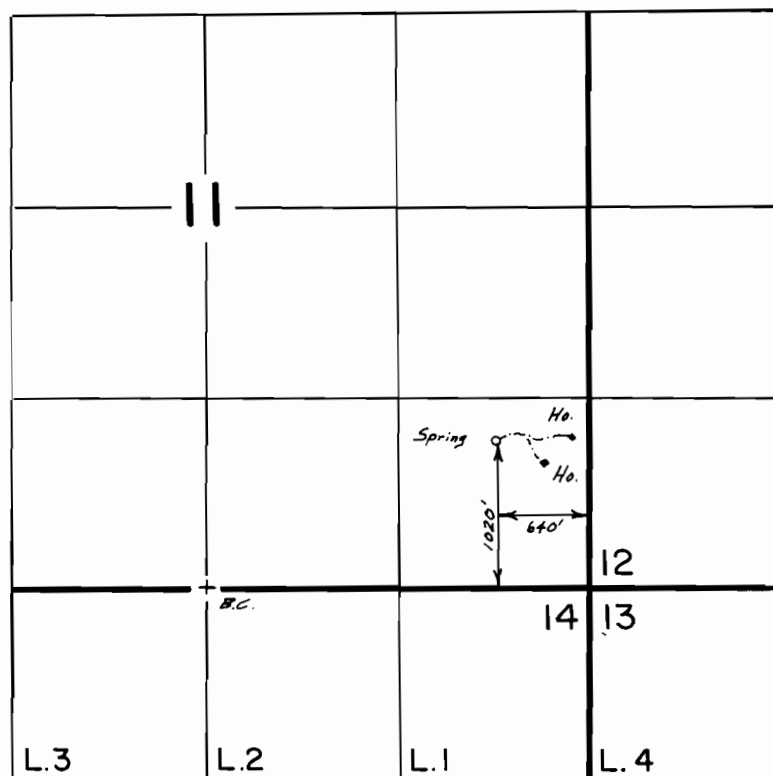

Scale 1" = 1320'

FINAL PROOF SURVEY
UNDER

Application No. 60339 Permit No. 44990
IN NAME OF

.....LEE.....G.....VAN.....DUZEE.....

Surveyed Oct. 1, 1987, by J.M. SCHMORDE