


T. 40S., R. 14 W., W. M.

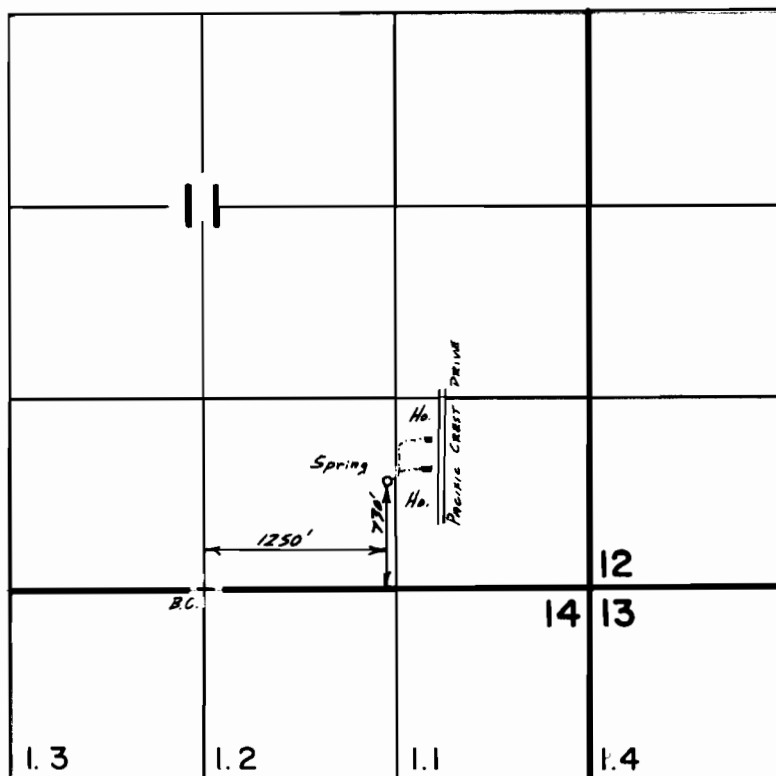

Scale 1" = 1320'

# FINAL PROOF SURVEY

UNDER

Application No. 60458. Permit No. 45070.....  
IN NAME OF

..... LEE G. VAN DUZEE .....

Surveyed Oct. 1, 1987, by J. M. SCHMORDE