


90884
T. 22 S., R. 5 W., W. M.

SECTION 30

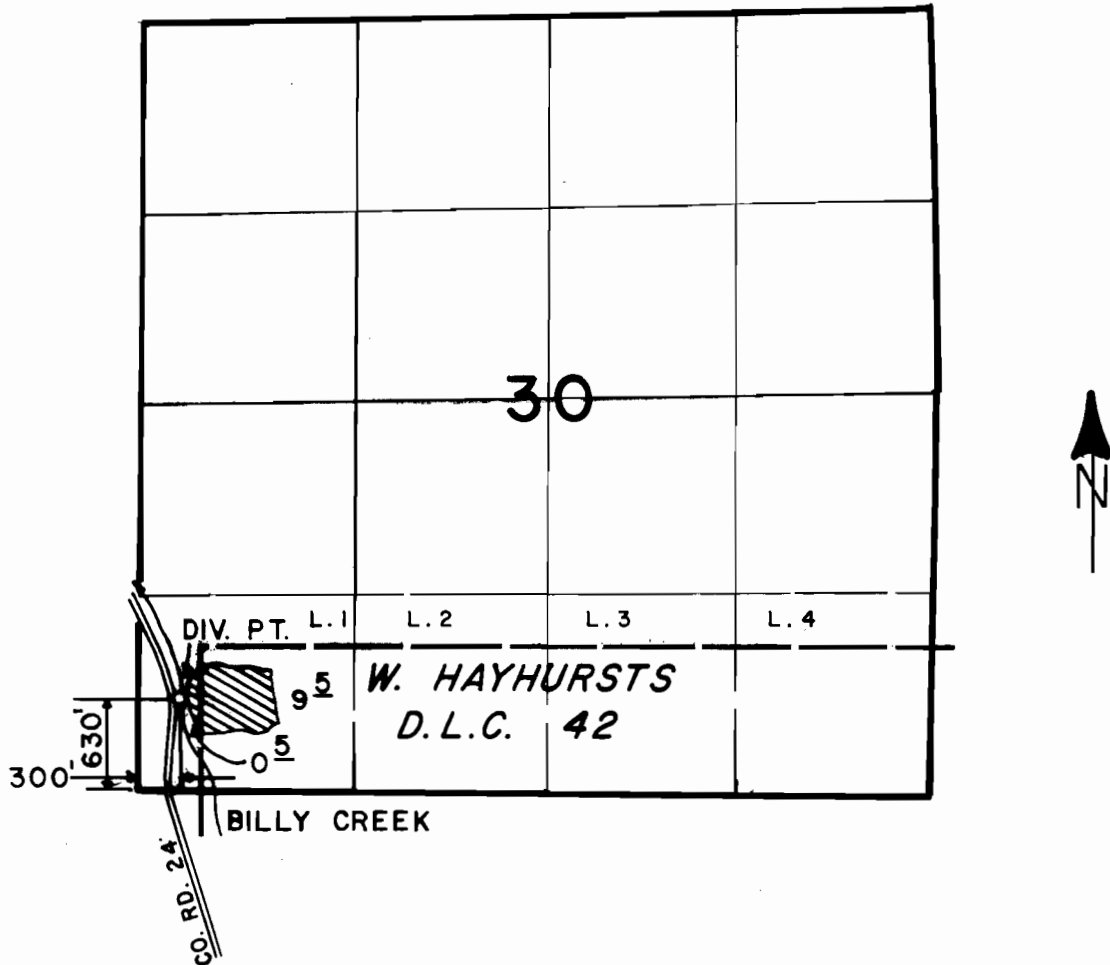

SCALE: 4" = 1 MILE

FINAL PROOF SURVEY
UNDER

Application No. 60442 Permit No. 45254
IN NAME OF

RICHARD M. OLSON

Surveyed OCT. 21, 1986, by J.M. SCHMORDE.