


T 28 S., R. 12 W., W. M.

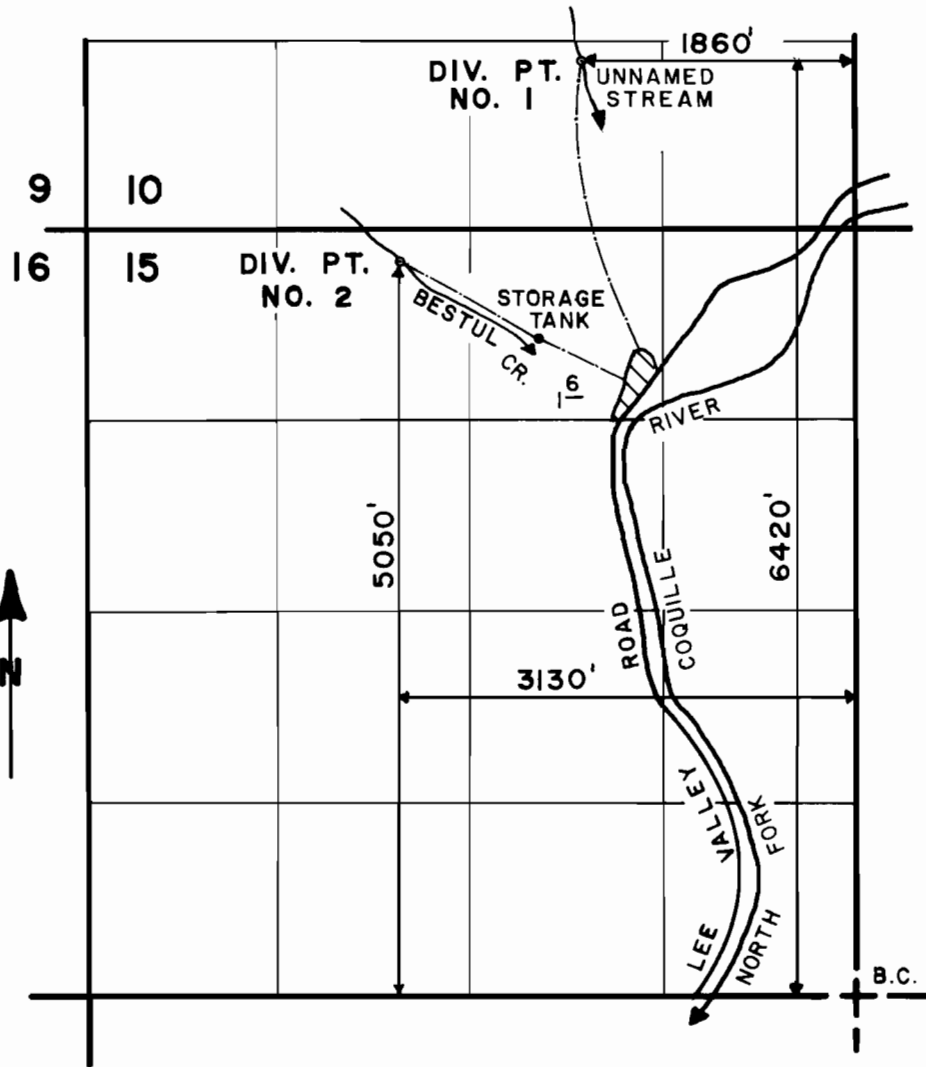

SCALE: 4" = 1 MILE

FINAL PROOF SURVEY
UNDER

Application No. 60495 Permit No. 45331.....
IN NAME OF

CECIL A. & BLANCH WELZHEIMER

Surveyed AUG. 29, 1985, by J.M. SCHMORDE