


T. 25 S., R. 5 W., W.M.

SECTION 20

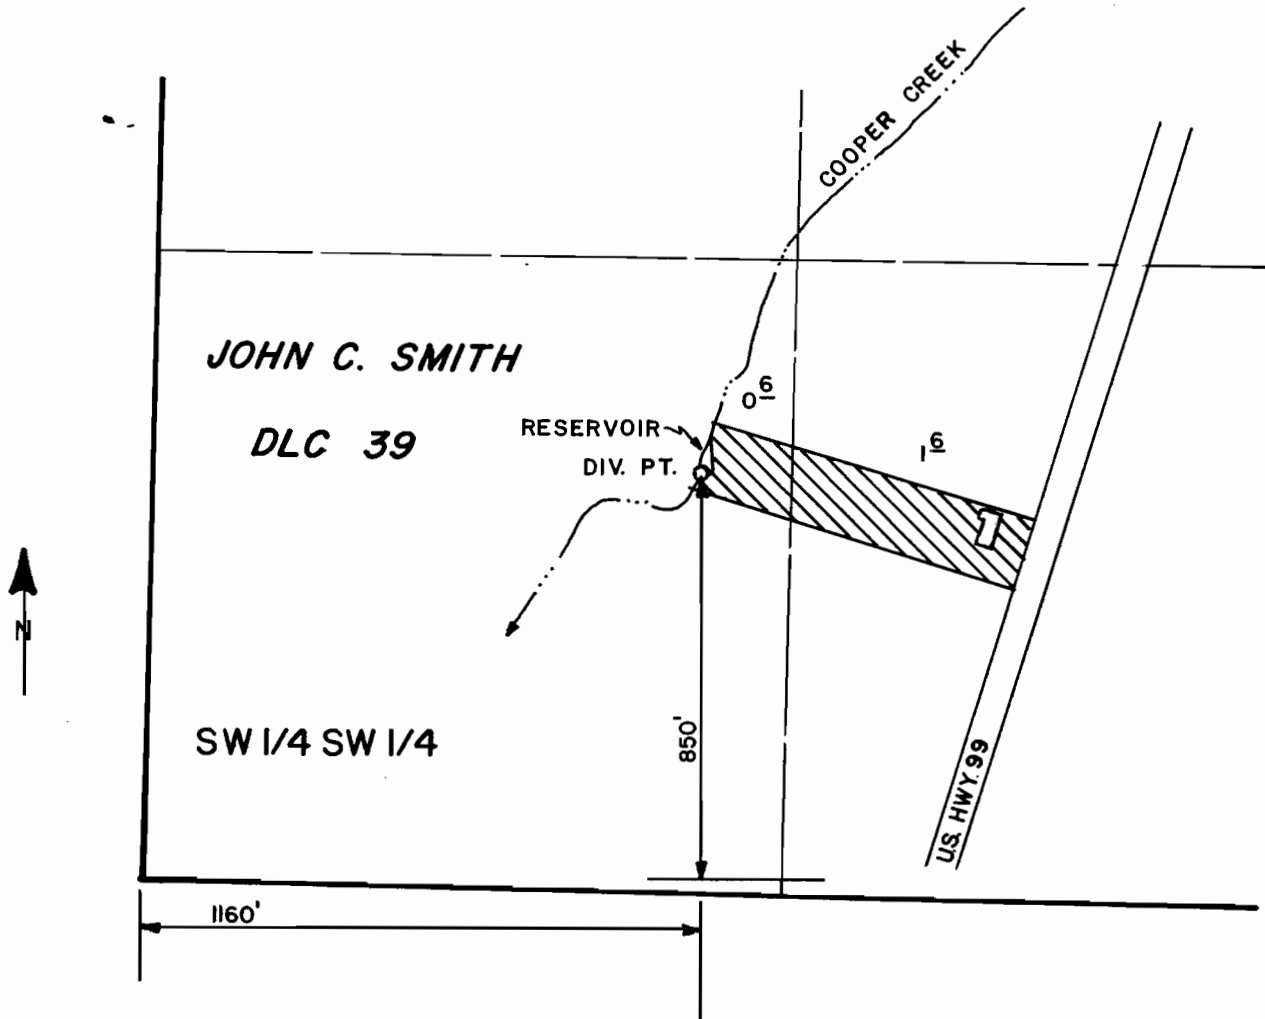

SCALE: 1" = 400'

FINAL PROOF SURVEY UNDER

R-60595

R-8314

Application No. 60596... Permit No. 46108.....

IN NAME OF

WILLIAM J. AND WANDA CRANFORD

Surveyed JULY 2, 1986, by J. M. SCHMORDE