


T. 30 S., R. 3 W., W.M.

SECTION 26

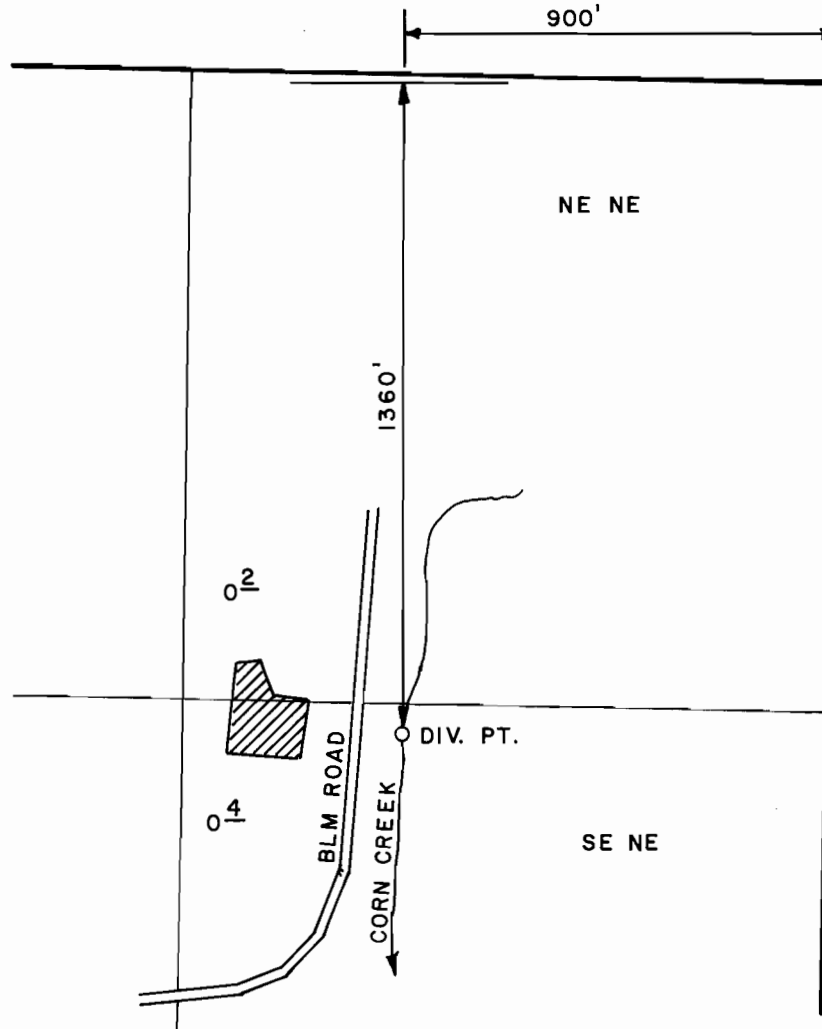

SCALE: 1" = 400'

FINAL PROOF SURVEY UNDER

Application No. 61346 Permit No. 45613
IN NAME OF

RICK & WENDY FOSTER

Surveyed JUNE 25, 1986, by J.M. SCHMORDE.