


T. 27S., R. 3W., W.M.

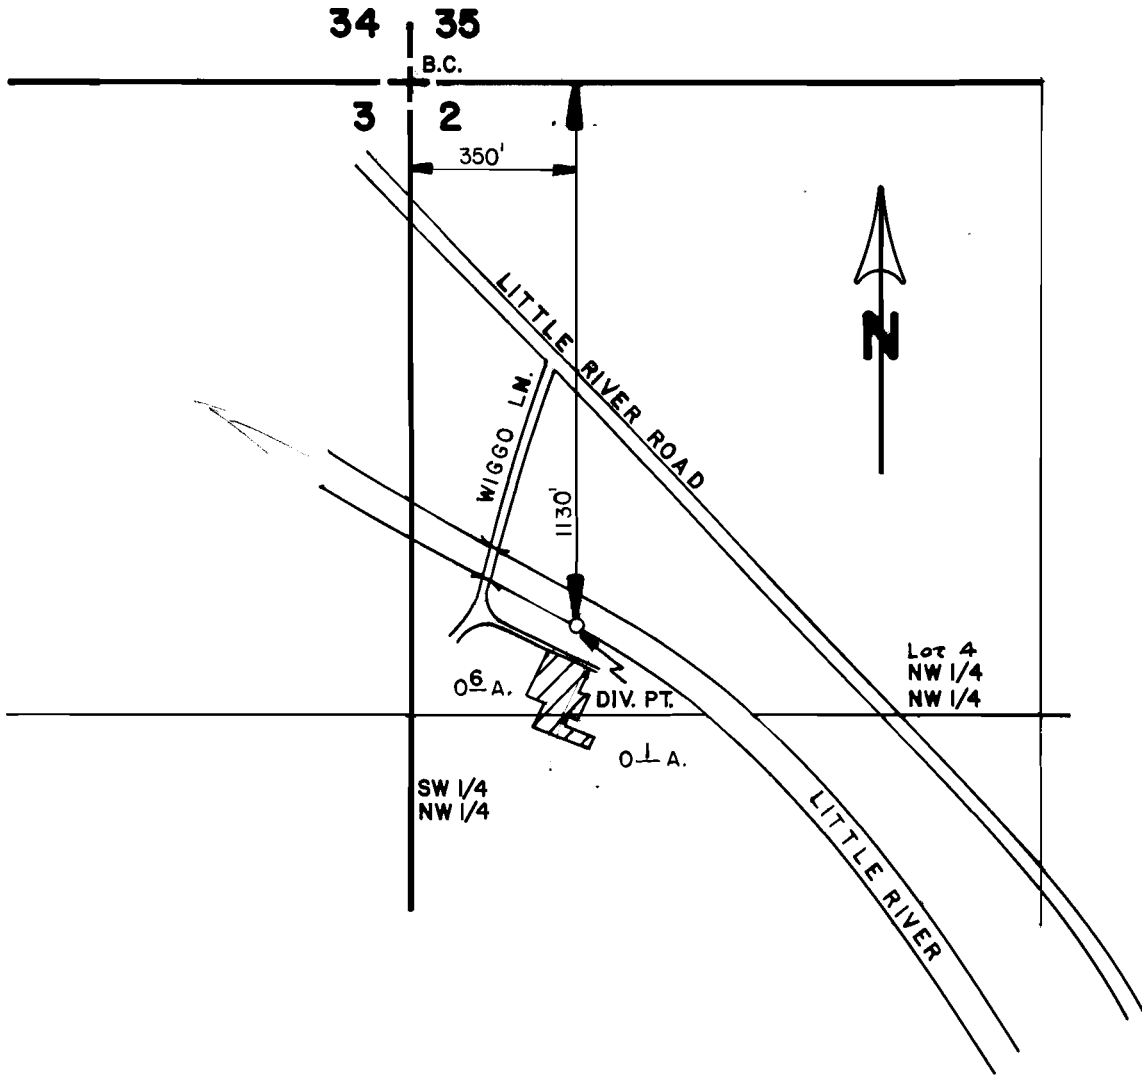

SCALE: 1" = 400'

**FINAL PROOF SURVEY**  
UNDER

Application No. 61707 Permit No. 45815  
IN NAME OF

**SCOTT, SUSAN**

Surveyed JULY 18 1984, by D.K. CLARK