


SECTION

TOWNSHIP 35, RANGE 3E, W. M.

North

Application No. 61928  
Permit No.

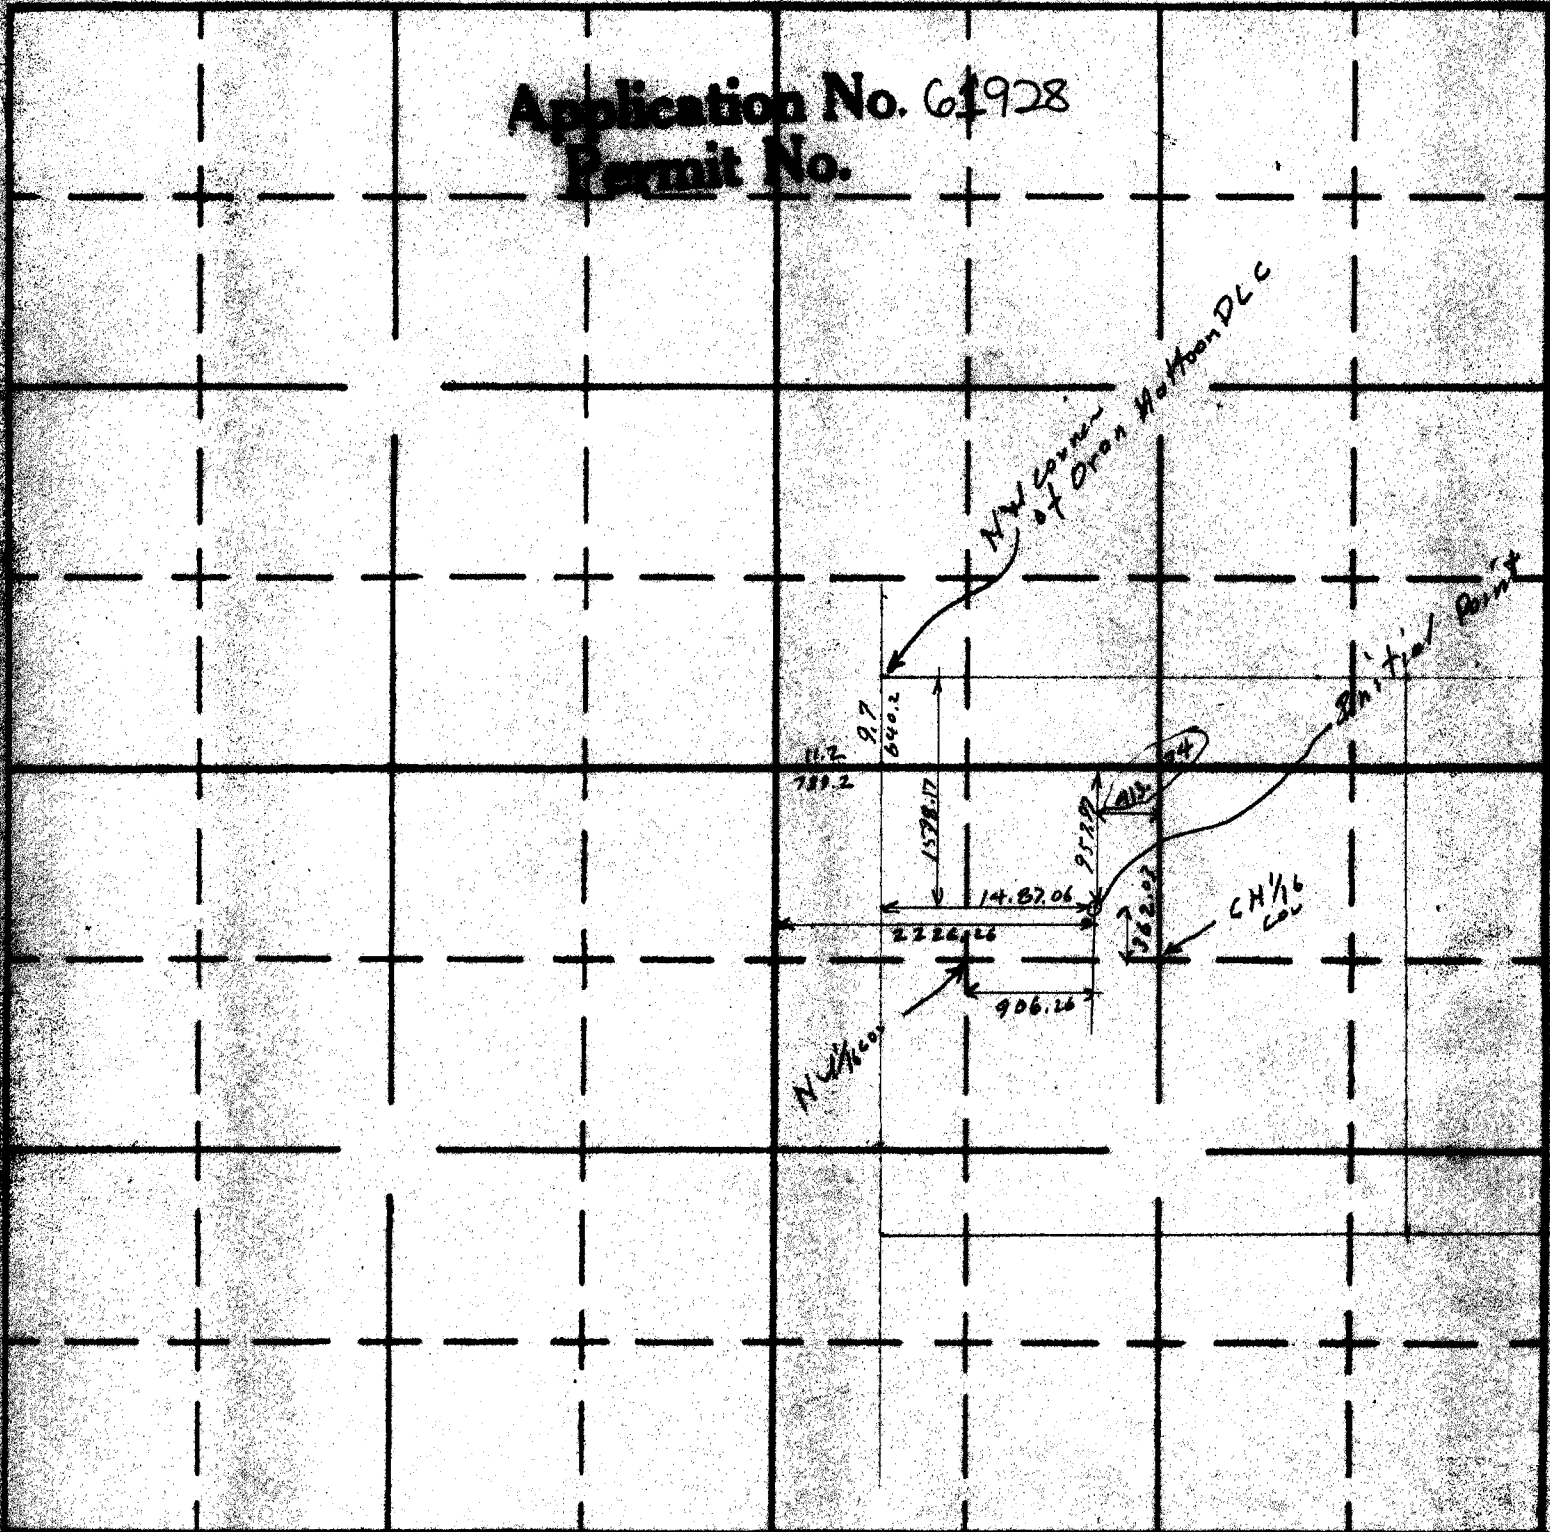

South

APPLICATION No.  
PERMIT No.