


T.37S., R.6 W., W.M.

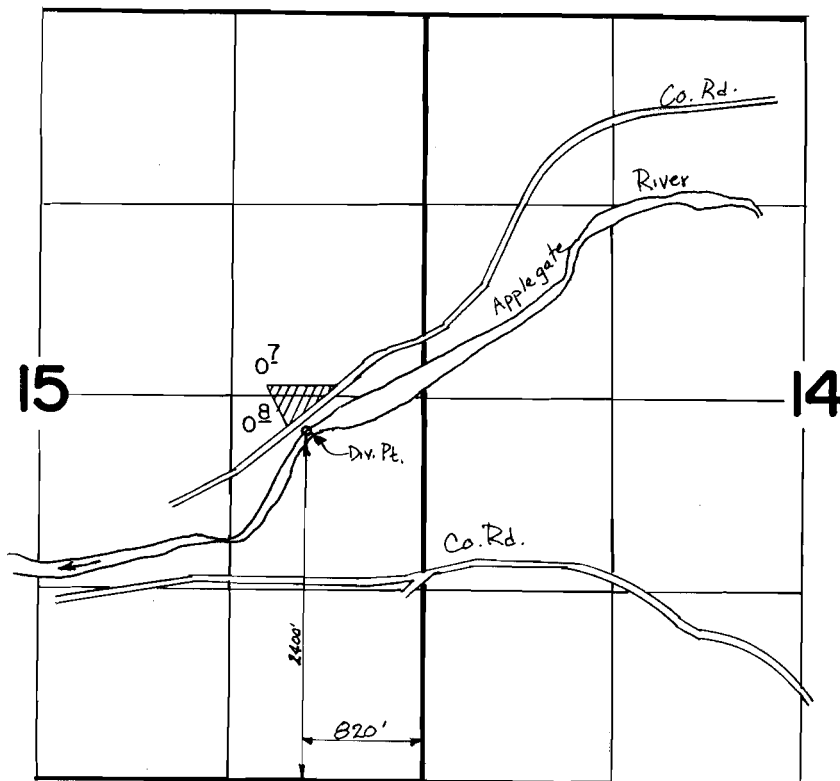

FINAL PROOF SURVEY UNDER

Application No. 62200... Permit No. 46078.....
IN NAME OF

DAN MCLOUD

Surveyed OCT...19... 1983.., by .B.S..JAMES.....