


T. 26 S., R. 3 W., W. M.

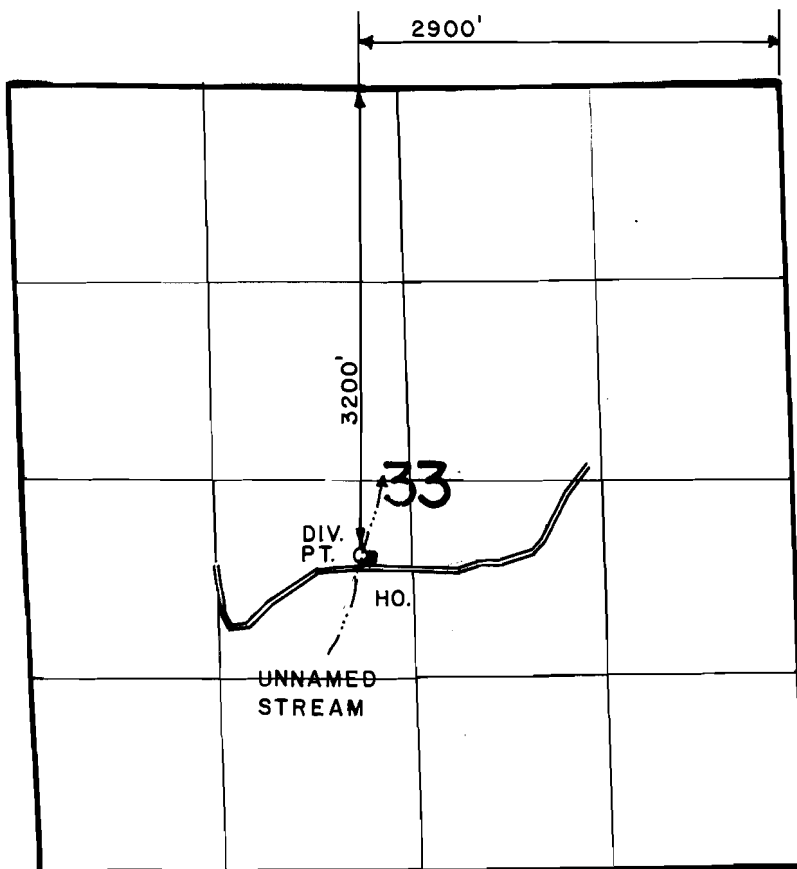

SCALE: 4" = 1 MILE

FINAL PROOF SURVEY
UNDER

Application No. 62548 Permit No. 46553
IN NAME OF

PAMELA KAYE HALLCRAFT

Surveyed OCT. 2, 1986, by J. M. SCHMORDE