
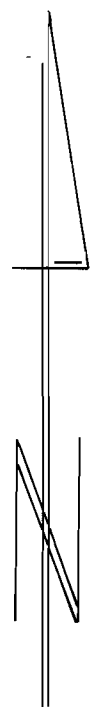


T17S R9W WM

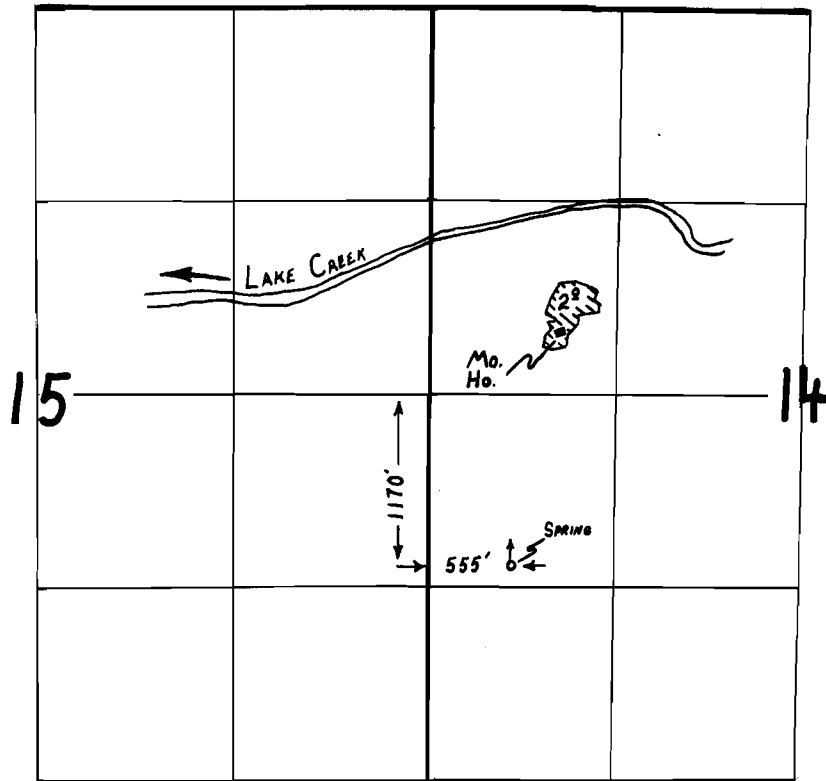

1" = 1320'

FINAL PROOF SURVEY UNDER

Application No. 62606 Permit No. 47026
IN NAME OF

GERALD & MARIE UPSHAW

Surveyed June 14 1990, by L. H. Nunn