




T.17 S., R. 5 W., W.M.

SECTION 20

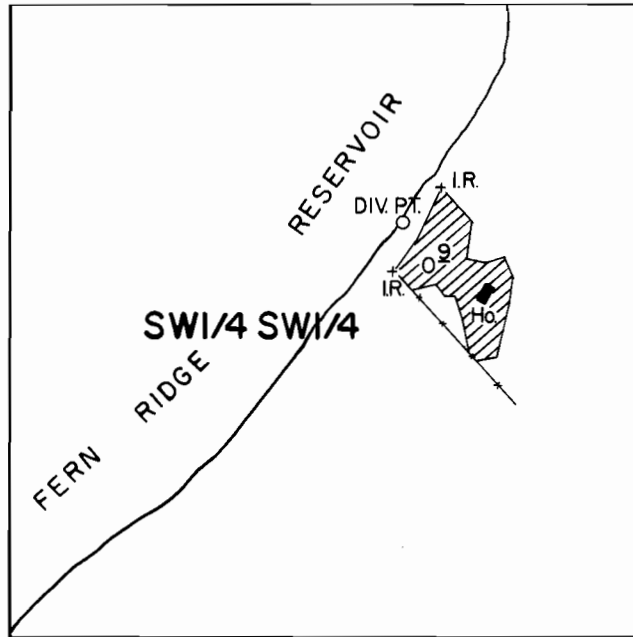

DIV. PT. LOC: 870' N. & 820' E. FROM SW. CORNER SEC. 20

SCALE: 1" = 400'

FINAL PROOF SURVEY
UNDER

Application No. 63496.. Permit No. 47762.....

IN NAME OF

CRAIG T. & DONNA M. LEAVY

Surveyed OCT. 14. 1986., by T. WARREN.....